

Walthall
729
11-67

MISSISSIPPI
BOARD OF WATER COMMISSIONERS
416 North State Street
Jackson, Mississippi 39201

WATER WELL DRILLERS LOG

11-6 1967 Silvanus W. Whinnie Walthall
date well completed firm name county well located

LANDOWNER: E.H. Fortenberry
Tylertown RT MISS
(mailing address)

description of formations encountered	from	to
top soil & clay	0	18
red sand	18	50
gravel & sand	50	60
fine sand	60	155
coarse sand & gravel	155	170


WELL LOCATION:
sec 27 T 2 N 11 E
S W
4 miles E of Tylertown
(distance) (direction) (nearest town)

WELL PURPOSE: home
(home, irrigation, municipal, industrial)

WELL COMPLETION DATA:

- (1) diameter (inches) 4
- (2) total depth (feet) 170
- (3) static water level (feet) 60 below above top of ground.
- (4) casing plastic 164
(material) (depth)
4 if telescope see back.
(size)
- (5) screen 6" 164
(length) (depth to top)
4 plastic
(size) (material)
- (6) pump 1/2 HP 500
(HP) (yield gpm)
5hp
(type power)
- (7) electric log no
(yes or no)
Mad peg
(organization running log)
- (8) how well bottom plugged


CODED

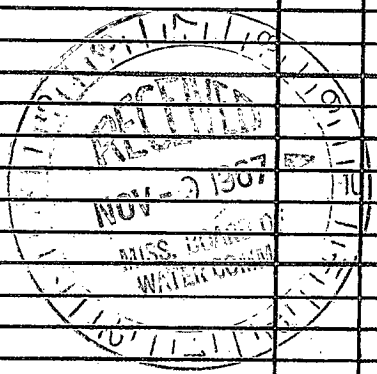

DRILLERS REMARKS:

If well telescopes please sketch and show depths.

GROUND LEVEL

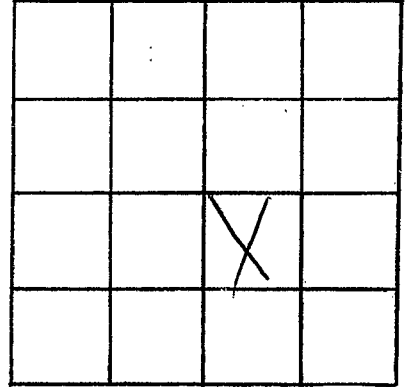

SECTION 27

Please indicate well location X.

ADDITIONAL INFORMATION

If more than one screen, show locations of each on sketch.