

MISSISSIPPI
 BOARD OF WATER COMMISSIONERS
 416 North State Street
 Jackson, Mississippi 39201

WATER WELL DRILLERS LOG

Walthall
 730
 1-68

CODED

1-18 date well completed
 18 Fitzgerald Water Well firm name
 Walthall county well located

LANDOWNER: Geo Anderson
~~Walthall~~ Tylertown RA
Miss
 (mailing address)

description of formations encountered	from	to
topsoil/clay	0	20
Chalky Sand	20	25
Sand/gravel	25	94
Fine Sand	94	125
gravel	125	134

WELL LOCATION:
 sec 24 T 2 N R 11 E
6 miles E of Tylertown
 (distance) (direction) (nearest town)


WELL PURPOSE: home
 (home, irrigation, municipal, industrial)

- WELL COMPLETION DATA:
- (1) diameter (inches) 4
 - (2) total depth (feet) 134
 - (3) static water level (feet) 95 below above top of ground.
 - (4) casing plastic 128
 (material) (depth)
4 If telescope see back.
 (size)
 - (5) screen 6', 128
 (length) (depth to top)
4, plastic
 (size) (material)
 - (6) pump - -
 (HP) (yield gpm)
3hp
 (type power)
 - (7) electric log no
 (yes or no)

CODED


(organization running log)
 (8) how well bottom plugged Wood peg

DRILLERS REMARKS:

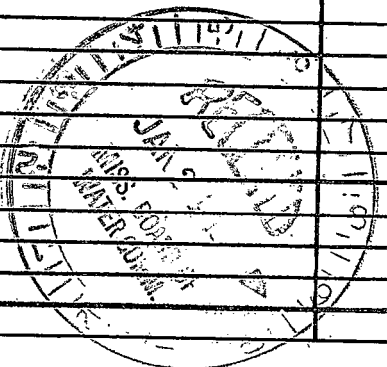

If well telescopes please sketch and show depths.

GROUND LEVEL

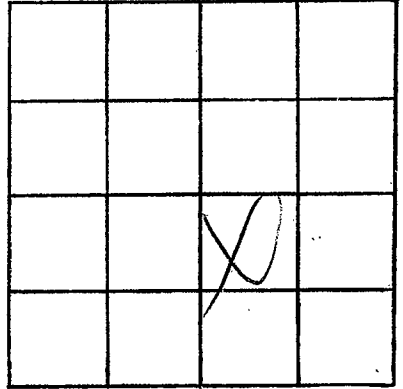

SECTION 24

Please indicate well location X.

ADDITIONAL INFORMATION

If more than one screen,
show locations of each on sketch.