

Walthall
731
1-68

MISSISSIPPI
BOARD OF WATER COMMISSIONERS
416 North State Street
Jackson, Mississippi 39201

INDEX

WATER WELL DRILLERS LOG

1-18-68 Leggers W Water Well Walthall
date well completed firm name county well located

LANDOWNER: Swift Fertilizer
~~Leggers W Water Well~~
Tylertown RL MISS
(mailing address)

description of formations encountered	from	to
Sand	0	42
Chalk	42	61
Fine Sand	61	122
Coarse Sand	122	128


WELL LOCATION:
sec. 28 T. 11 N. R. 2 E.
2 miles (distance) SE (direction) of Tylertown (nearest town)

WELL PURPOSE: Industrial
(home, irrigation, municipal, industrial)

WELL COMPLETION DATA:

- (1) diameter (inches) 4
- (2) total depth (feet) 128
- (3) static water level (feet) 4 below above top of ground.
- (4) casing plastic 122
(material) (depth)
4 (size) if telescope see back.
- (5) screen 6' 122
(length) (depth to top)
4 (size) plastic (material)
- (6) pump Spec
(HP) (yield gpm)
(type power)
- (7) electric log NO
(yes or no)
(organization running log)
- (8) how well bottom plugged Wood peg

INDEX

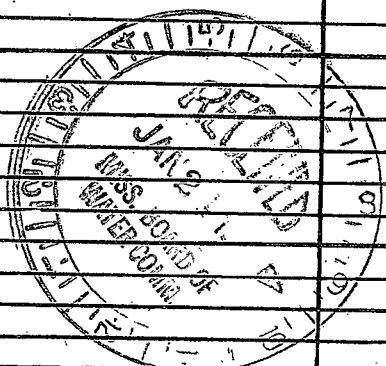

DRILLERS REMARKS:

