

Walthall
732
2-68

CODED

MISSISSIPPI
BOARD OF WATER COMMISSIONERS
416 North State Street
Jackson, Mississippi 39201

WATER WELL DRILLERS LOG

Feb 1 1968 Fitzgould Well Serv. Walthall
date well completed firm name county well located

LANDOWNER: Lynwood & Sons
R.R.

Tylutown, Miss
(mailing address)

WELL LOCATION:
sec. 24 T. 2 N R. 11 E
8 miles ESE of Tylutown
(distance) (direction) (nearest town)

WELL PURPOSE: Home
(home, irrigation, municipal, industrial)

WELL COMPLETION DATA:


- (1) diameter (inches) 4"
- (2) total depth (feet) 135'
- (3) static water level (feet) 70 below above top of ground.
- (4) casing Plastic, 129'
(material) (depth)
4" if telescope see back.
(size)
- (5) screen 6', 129'
(length) (depth to top)
4", Plastic
(size) (material)
- (6) pump ? ?
(HP) (yield gpm)
Ch
(type power)
- (7) electric log no
(yes or no)

(organization running log)
- (8) how well bottom plugged Wooden

DRILLERS REMARKS:


description of formations encountered	from	to
white sand	0	20
Red Clay	20	70
Red gravel	40	50
Red Chalk	50	70
white chalk	70	80
Red sand	80	90
course soil & gravel	90	102
Red sand	102	125
course sand	125	135

CODED

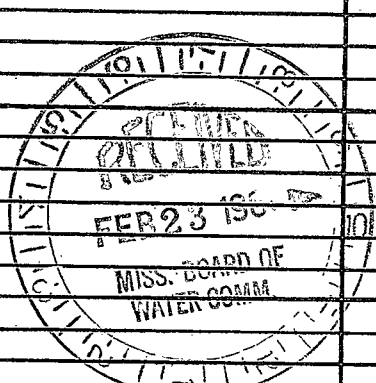

If well telescopes please sketch and show depths.

GROUND LEVEL

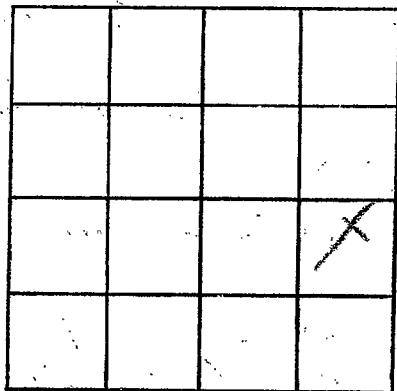

SECTION 24

Please indicate well location X.

ADDITIONAL INFORMATION

If more than one screen, show locations of each on sketch.