

WALTHALL

F 33

4-68

CODED

MISSISSIPPI
 BOARD OF WATER COMMISSIONERS
 416 North State Street
 Jackson, Mississippi 39201

WATER WELL DRILLERS LOG

4-19 1968 Gregerson Water Well WFL Hall
 date well completed firm name county well located

LANDOWNER: Floyd Regan

description of formations encountered

from to

RTS Tyler town Miss
 (mailing address)

top soil - clay 0 20
Red sand 20 62
light gravel 62 68
sand 68 86
gravel 86 92
shale 92

WELL LOCATION:

sec 26 T 2 N R 11 E
5 miles E of Tylertown
 (distance) (direction) (nearest town)

WELL PURPOSE: home
 (home, irrigation, municipal, industrial)

WELL COMPLETION DATA:

- (1) diameter (inches) 4
- (2) total depth (feet) 92
- (3) static water level (feet) 65 below above top of ground.
- (4) casing plastic, 86
 (material) (depth)
4" if telescope see back.
 (size)
- (5) screen 6', 86
 (length) (depth to top)
4 Sch 40
 (size) (material)
- (6) pump 1 1/2 10
 (HP) (yield gpm)
Elec
 (type power)
- (7) electric log no
 (yes or no)
- (organization running log)
- (8) how well bottom plugged yes

CODED


APR 26 1968

MISS. BD. OF
 WATER COMMISSIONERS

DRILLERS REMARKS:

If well telescopes please sketch and show depths.

GROUND LEVEL

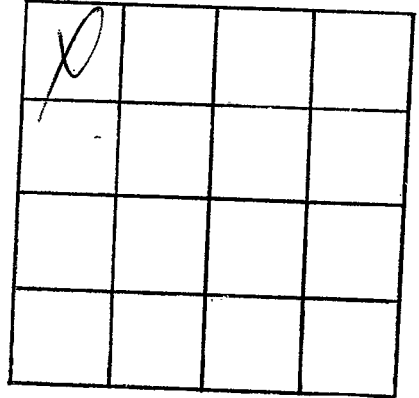

SECTION *26*

Please indicate well location X.

ADDITIONAL INFORMATION

If more than one screen,
show locations of each on sketch.