

WALTHALL
F35
4-68

MISSISSIPPI
BOARD OF WATER COMMISSIONERS
416 North State Street
Jackson, Mississippi 39201

WATER WELL DRILLERS LOG

April 23 1968 Reynolds & Humphreys Walthall
date well completed firm name county well located

CODED

LANDOWNER: Salunahert
Maagel
RFD #1, Bostons
(mailing address)

description of formations encountered	from	to
red clay	0	16
red cherty sand	16	36
red sand & silt with small amount gravel	36	90
gravel & sand	90	112
white chalk	112	136
coarse sand	136	149


WELL LOCATION:
sec 17 T 2 N R 11 E
3.4 miles NE of Bostons
(distance) (direction) (nearest town)

WELL PURPOSE: Home
(home, irrigation, municipal, industrial)

WELL COMPLETION DATA:

- (1) diameter (inches) 4"
- (2) total depth (feet) 149'
- (3) static water level (feet) 90 below top of ground.
- (4) casing Plastic, ballam
(material) (depth)
- (size) if telescope see back,
- (5) screen 6" 143'
(length) (depth to top)
- 4" Plastic
(size) (material)
- (6) pump 1/2" Sub 1"
(HP) (yield gpm)
- Elect
(type power)
- (7) electric log no
(yes or no)

CODED

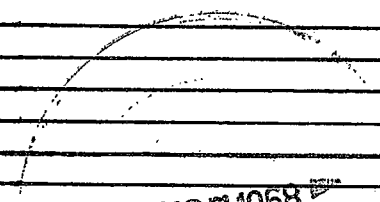

MAY 27 1968
MISS. BOARD OF
WATER COMMISSIONERS


(organization running log)

(8) how well bottom plugged wooden plug

DRILLERS REMARKS: red well pad

If well telescopes please sketch and show depths.

GROUND LEVEL

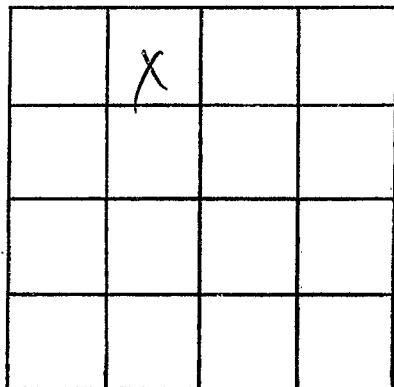

SECTION 17

Please indicate well location X.

ADDITIONAL INFORMATION

If more than one screen, show locations of each on sketch.