

Walthall  
736  
3-31-67

MISSISSIPPI  
BOARD OF WATER COMMISSIONERS  
416 North State Street  
Jackson, Mississippi 39201

67 WATER WELL DRILLERS LOG

MARCH 31 1967 Fennie + Elbert Brown WALTHALL  
date well completed firm name county well located

LANDOWNER:  
Gordon Rushing  
TYLETOWN  
(mailing address)


description of formations encountered	from	to
White Clay	0	18
SAND & GRAVEL	18	50

WELL LOCATION:  
sec. 29 T 20 N R 11 E S 1 W  
1 miles E of Tyletown  
(distance) (direction) (nearest town)

WELL PURPOSE: Home  
(home, irrigation, municipal, industrial)

- WELL COMPLETION DATA:
- (1) diameter (inches) 4"
  - (2) total depth (feet) 50'
  - (3) static water level (feet) 36' below top of ground.
  - (4) casing PLASTIC 50' (material) (depth)  
4" (size) if telescope see back.
  - (5) screen 5' 45" (length) (depth to top)  
4" PLASTIC (size) (material)
  - (6) pump 1/2 5 GPM (HP) (yield gpm)  
ELECT (type power)
  - (7) electric log \_\_\_\_\_ (yes or no)  
\_\_\_\_\_  
(organization running log)
  - (8) how well bottom plugged BWV


CODED

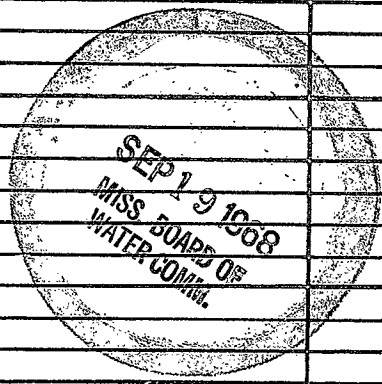

DRILLERS REMARKS: Jet Pump  
2 Pipe

If well telescopes please sketch and show depths.

GROUND LEVEL

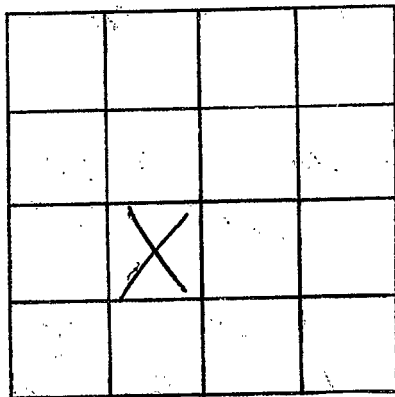

SECTION 29

Please indicate well location X.

ADDITIONAL INFORMATION

If more than one screen, show locations of each on sketch.