

**MISSISSIPPI
BOARD OF WATER COMMISSIONERS**
416 North State Street
Jackson, Mississippi 39201

WATER WELL DRILLERS LOG

Walthall
737
6-27-67 **CODED**

6-27 date well completed 1967 Hermit Albert Brown firm name Walthall county well located

LANDOWNER:

Ollie Brumfield
Tylertown Miss.
(mailing address)

description of formations encountered

from to

RED CLAY	0	110
RED SAND + GRAVEL	110	100
SAND	100	134
SAND + GRAVEL	134	145

WELL LOCATION:

sec. 25 T. 20 (N) R. 11 (E)
S W
6 miles E of Tylertown
(distance) (direction) (nearest town)

WELL PURPOSE:


HOME
(home, irrigation, municipal, industrial)

WELL COMPLETION DATA:

- (1) diameter (inches) 4"
- (2) total depth (feet) 145'
- (3) static water level (feet) 112 ^{below}/_{above} top of ground.
- (4) casing plastic, 145'
(material) (depth)
4"
(size) if telescope see back.
- (5) screen 5', 140'
(length) (depth to top)
1", plastic
(size) (material)
- (6) pump 1/2, 8
(HP) (yield gpm)
Elect
(type power)
- (7) electric log _____
(yes or no)

(organization running log)
- (8) how well bottom plugged W V

CODED

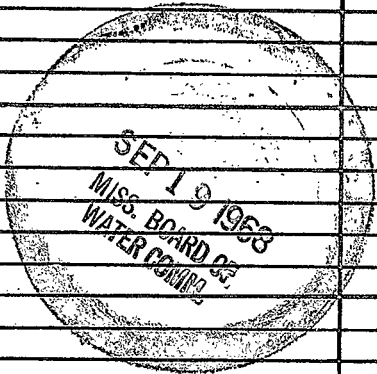

DRILLERS REMARKS:

Submersible Pump

If well telescopes please sketch and show depths.

GROUND LEVEL

	X		

SECTION 25

Please indicate well location X.

ADDITIONAL INFORMATION

If more than one screen, show locations of each on sketch.