

Walthall
F 38
8-67

CODED

MISSISSIPPI
BOARD OF WATER COMMISSIONERS
416 North State Street
Jackson, Mississippi 39201

WATER WELL DRILLERS LOG

8-25 1968 68 Reynolds Water Well Walthall
date well completed firm name county well located

LANDOWNER: Billy McNeil
Tyler Town Pt MS
(mailing address)

description of formations encountered	from	to
<u>top soil & clay</u>	<u>0</u>	<u>12</u>
<u>sand</u>	<u>12</u>	<u>30</u>
<u>sandy-gravel</u>	<u>30</u>	<u>60</u>
<u>chert</u>	<u>60</u>	<u>110</u>
<u>fine sand</u>	<u>110</u>	<u>150</u>
<u>medium sand</u>	<u>150</u>	<u>165</u>
<u>coarse sand</u>	<u>165</u>	<u>170</u>
<u>gravel</u>		

WELL LOCATION:
sec. 18 T 2 N R. 11 E
S W
2 miles W of Tyler town
(distance) (direction) (nearest town)

WELL PURPOSE: home
(home, irrigation, municipal, industrial)

WELL COMPLETION DATA:


- (1) diameter (inches) 4
- (2) total depth (feet) 170
- (3) static water level (feet) 40 below above top of ground.
- (4) casing plastic (material) 170 (depth)
4 if telescope see back. (size)
- (5) screen 6' (length) 164 (depth to top)
4 (size) sch 40 (material)
- (6) pump (HP) (yield gpm)
Spec
- (7) electric log no (yes or no)

(organization running log)

(8) how well bottom plugged plugged


DRILLERS REMARKS:

CODED

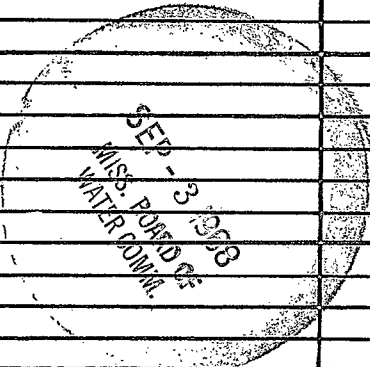

If well telescopes please sketch and show depths.

GROUND LEVEL

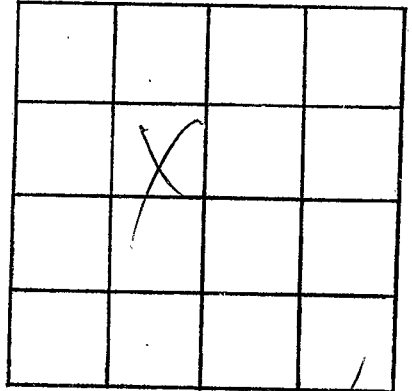

SECTION 18

Please indicate well location X.

ADDITIONAL INFORMATION

If more than one screen, show locations of each on sketch.