

Walthall  
739  
10-18-67

MISSISSIPPI  
BOARD OF WATER COMMISSIONERS  
416 North State Street  
Jackson, Mississippi 39201

WATER WELL DRILLERS LOG

10-18 date well completed  
1967 Fernie & Albert Brown firm name  
Walthall county well located

LANDOWNER:  
Sam Bridges  
Rt 5 Tybertown  
(mailing address)


description of formations encountered	from	to
sands & gravels	0	20
white clay	20	110
sand & gravel	110	142

WELL LOCATION:  
sec. 18 T. 20 N. R. 11 E  
2 miles N of Tybertown  
(distance) (direction) (nearest town)

WELL PURPOSE: Home  
(home, irrigation, municipal, industrial)

- WELL COMPLETION DATA:
- (1) diameter (inches) 4"
  - (2) total depth (feet) 142'
  - (3) static water level (feet) 70' (below top of ground)
  - (4) casing Plastic, 142' (material) (depth)  
4" (size) if telescope see back.
  - (5) screen 5' length, 137' depth to top  
4" (size), plastic (material)
  - (6) pump 1/2 HP (type power), 4 (yield gpm)
  - (7) electric log \_\_\_\_\_ (yes or no)  
\_\_\_\_\_  
(organization running log)
  - (8) how well bottom plugged W V


COPIED

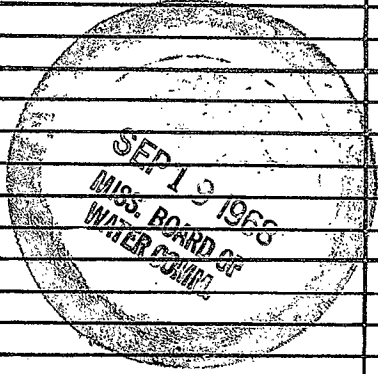

DRILLERS REMARKS: Jet Pump

If well telescopes please sketch and show depths.

GROUND LEVEL

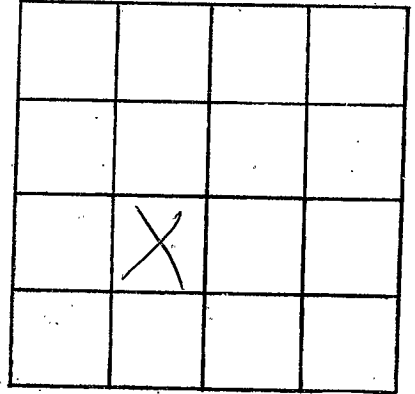

SECTION 18

Please indicate well location X.

ADDITIONAL INFORMATION

If more than one screen,  
show locations of each on sketch.