

Walthall  
741  
9-25-69

MISSISSIPPI  
BOARD OF WATER COMMISSIONERS  
416 North State Street  
Jackson, Mississippi 39201

CODED  
CODED

WATER WELL DRILLERS LOG

9-25 1969 Flygarden well in Walthall  
date well completed firm name county well located


LANDOWNER:	description of formations encountered	from	to
ab Stewart			
RR. Tylerston main (mailing address)	Real clay course sand white chalk course sand	0 15 22 48	15 22 48 54
WELL LOCATION: sec 7 T 2 N R 11 E S W			
2 miles N of Tylerston (distance) (direction) (nearest town)			
WELL PURPOSE: <u>Home</u> (home, irrigation, municipal, industrial)			
WELL COMPLETION DATA:			
(1) diameter (inches) <u>4</u>			
(2) total depth (feet) <u>54</u>			
(3) static water level (feet) <u>17</u> below top of ground.			
(4) casing <u>plastic</u> (material) (depth) (size) if telescope see back.			
(5) screen <u>Bar</u> (length) (depth to top) (size) (material)			
(6) pump <u>3/4</u> <u>15</u> (HP) (yield gpm) <u>elec</u> (type power)			
(7) electric log <u>no</u> (yes or no) (organization running log)			
(8) how well bottom plugged <u>woolly</u>			
DRILLERS REMARKS:			

OCT 20 1969

MISS. BD. OF  
WATER CONTROL

If well telescopes please sketch and show depths.

GROUND LEVEL

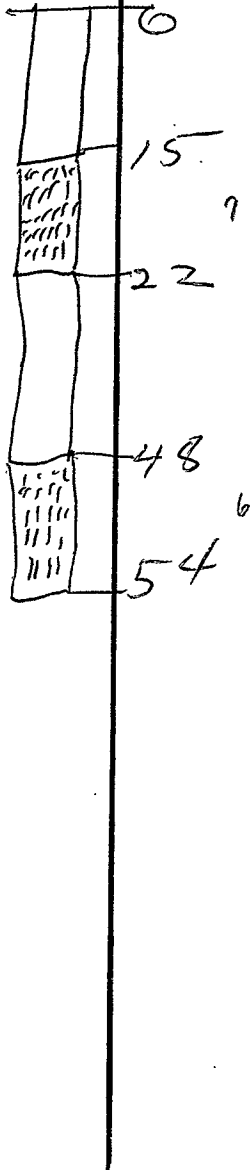

			X

SECTION ~~#~~ 7

Please indicate well location X.

ADDITIONAL INFORMATION

If more than one screen,  
show locations of each on sketch.