

WALTHALL  
R 42  
6-7-69

MISSISSIPPI  
BOARD OF WATER COMMISSIONERS  
416 North State Street  
Jackson, Mississippi 39201

CODED  
CODED

WATER WELL DRILLERS LOG

June 7 1969 below well 100 ft - Walthall -  
date well completed firm name county well located

LANDOWNER: Mayor's Club  
Colored Church  
KFD, Tylertown  
(mailing address)

description of formations encountered	from	to
Red sandy clay	0	19
Red sand with some gravel	19	106
Red gravel clay	106	119
Red chalk	119	124
Sand and small gravel	124	138

WELL LOCATION:  
sec. 16 T 2 N R 11 E  
4 miles NE of Tylertown  
(distance) (direction) (nearest town)

WELL PURPOSE: Church  
(home, irrigation, municipal, industrial)

- WELL COMPLETION DATA:
- (1) diameter (inches) 4"
  - (2) total depth (feet) 138
  - (3) static water level (feet) 114 <sup>below</sup> ~~above~~ top of ground.
  - (4) casing Plastic Bottom  
(material) (depth)
  - (size) If telescope see back.
  - (5) screen 6' 137'  
(length) (depth to top)
  - 4" Plastic  
(size) (material)
  - 3/4" pump 1.5  
(HP) (yield gpm)
  - Elect.  
(type power)
  - (7) electric log No  
(yes or no)

(organization running log)


(8) how well bottom plugged  
wooden plug

DRILLERS REMARKS:

AUG 11 1969  
MISSISSIPPI BOARD OF WATER COMMISSIONERS

If well telescopes please sketch and show depths.

GROUND LEVEL

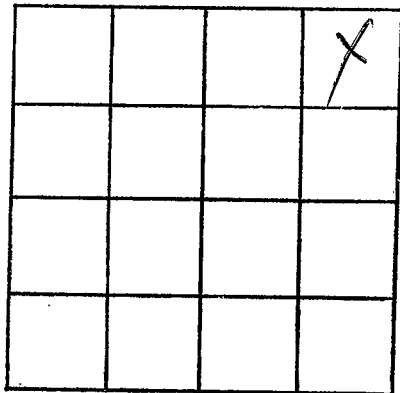

SECTION 16

Please indicate well location X.

ADDITIONAL INFORMATION

If more than one screen,  
show locations of each on sketch.