

WALTHALL

F 43

8-22-69

MISSISSIPPI BOARD OF WATER COMMISSIONERS 416 North State Street Jackson, Mississippi 39201

CODED

CODED

WATER WELL DRILLERS LOG

Aug 22 1969 Keener Well Drilling Co. Walthall
date well completed firm name county well located

LANDOWNER: Dennis Thomas
RD - Tylertown
(mailing address)

Table with 3 columns: description of formations encountered, from, to. Rows include Red clay, Red Sand, Sand & gravel, Red chert, Red sandy sand, fine sand, Coarse sand.

WELL LOCATION: sec 26 T 2 N R 11 E
5 miles E of Tylertown
(distance) (direction) (nearest town)

WELL PURPOSE: home
(home, irrigation, municipal, industrial)

WELL COMPLETION DATA:

- (1) diameter (inches) 4"
(2) total depth (feet) 185
(3) static water level (feet) 58 below top of ground
(4) casing Plastic bottom
(5) screen 6' 179'
(6) pump used old pump
(7) electric log no.

(organization running log)


(8) how well bottom plugged wooden plug

DRILLERS REMARKS: self well insufficient

Stamp: SEP 29 1969 MISS. DIV. OF WATER CONTROL

If well telescopes please sketch and show depths.

GROUND LEVEL

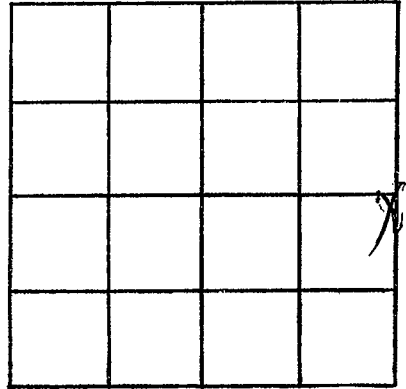

SECTION 26

Please indicate well location X.

ADDITIONAL INFORMATION

If more than one screen,
show locations of each on sketch.