

Walthall
F 46
2-70

MISSISSIPPI
BOARD OF WATER COMMISSIONERS
416 North State Street
Jackson, Mississippi 39201

CODED

WATER WELL DRILLERS LOG

FEB 1970 F.B. SHERRARD WALTHALL
date well completed firm name county well located

LANDOWNER:
FRED LEWIS
Rt. 1 - TYLERTOWN, MISS.
(mailing address)

description of formations encountered	from	to
<u>RED SANDY CLAY GRAVEL</u>	<u>0</u>	<u>60</u>
<u>GRAVEL & FINE SAND</u>	<u>60</u>	<u>80</u>
<u>GRAVEL & SMALL WATER SAND</u>	<u>80</u>	<u>95</u>

WELL LOCATION:
sec. 21 T. 2 S. R. 11 E.
2 1/2 miles E of TYLERTOWN
(distance) (direction) (nearest town)

WELL PURPOSE:
(home) irrigation, municipal, industrial

WELL COMPLETION DATA:

(1) diameter (inches) 2"

(2) total depth (feet) 95

(3) static water level (feet) 60 below top of ground.

(4) casing PL. (material) 95 (depth)
2" if telescope see back.
(size)

(5) screen 3' (length) 3' (depth to top)
2 1/2 (size) S.S. (material)

(6) pump 1 (HP) 7 (yield gpm)
E (type power)

(7) electric log (yes or no)
(organization running log)

(8) how well bottom plugged BWV

CODED


MAR 17 1970

DRILLERS REMARKS:

MISS. BD. OF
WATER COMM.

If well telescopes please sketch and show depths.

GROUND LEVEL

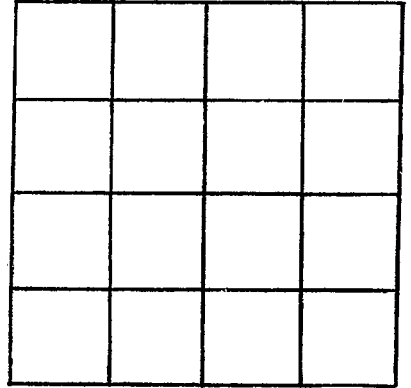

SECTION _____

Please indicate well location X.

ADDITIONAL INFORMATION

If more than one screen, show locations of each on sketch.