

MISSISSIPPI  
BOARD OF WATER COMMISSIONERS  
416 North State Street  
Jackson, Mississippi 39201

WATER WELL DRILLERS LOG



Walthall

F 48

2-27-70

2-27

date well completed

19

Fitzgerald Well Sew

firm name

Walthall

county well located

LANDOWNER:

Ben L. Magee

R.R. Tutwiler Miss

(mailing address)

WELL LOCATION:

sec 24 T 2 N R 11 E  
4 miles SSE of KNOX  
(distance) (direction) (nearest town)

WELL PURPOSE:

Home  
(home, irrigation, municipal, industrial)

WELL COMPLETION DATA:


- (1) diameter (inches) 4
- (2) total depth (feet) 124
- (3) static water level (feet) 85 below top of ground
- (4) casing Plastic, 116 (material) (depth)  
4 (size) if telescope see back.
- (5) screen 8 (length), 116 (depth to top)  
4 (size), Plastic (material)
- (6) pump 1/2 (HP), 10 (yield gpm)  
Cater (type power)
- (7) electric log no (yes or no)  
(organization running log)
- (8) how well bottom plugged wood plug

description of formations encountered

from

to

description of formations encountered	from	to
Red clay	2	25
Red sand	25	30
Red gravel	30	35
Red sand	30	110
Course sand & gravel	110	124

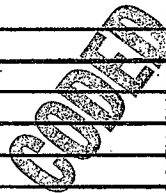


DRILLERS REMARKS:

MAR 10 1970

MISS. BD. OF  
WATER COMM.

If well telescopes please sketch and show depths.

GROUND LEVEL

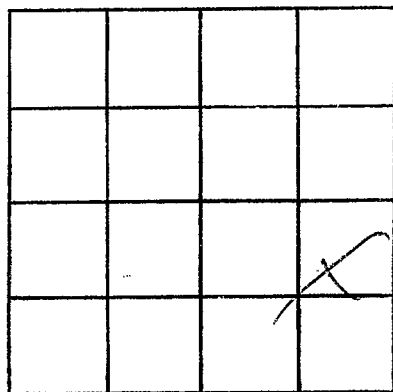

SECTION 24

Please indicate well location X.

ADDITIONAL INFORMATION

If more than one screen,  
show locations of each on sketch.