

Walthall  
F49  
3-2-70

MISSISSIPPI  
BOARD OF WATER COMMISSIONERS  
416 North State Street  
Jackson, Mississippi 39201

CODED

WATER WELL DRILLERS LOG

Mar 2 1970 To Fitzgerald Well Co. Walthall  
date well completed firm name county well located

LANDOWNER:  
Margaret Graves  
RR. Fulton, Miss.  
(mailing address)

description of formations encountered	from	to
Bed clay	0	20
Red sand	20	60
Red chalk	60	90
Red sand	90	92.5
Coarse sand & gravel	123	130

WELL LOCATION:  
sec. 34 T. 2 N. R. 11 E  
S W  
3 miles S of Knoka  
(distance) (direction) (nearest town)

WELL PURPOSE: Home  
(home, irrigation, municipal, industrial)

- WELL COMPLETION DATA:
- (1) diameter (inches) 4
  - (2) total depth (feet) 135
  - (3) static water level (feet) 85 below above top of ground.
  - (4) casing Plastic, 127, (material) (depth)  
4 (size) if telescope see back.
  - (5) screen 8, 137 (length) (depth to top)  
4 (size) Plastic (material)
  - (6) pump 1/2 (HP) 10 (yield gpm)  
Elec (type power)
  - (7) electric log Yes (yes or no)  
(organization running log)
  - (8) how well bottom plugged sand fill

CODED


MAR 10 1970

MISS. BD. OF  
WATER COMMISSIONERS

DRILLERS REMARKS:

If well telescopes please sketch and show depths.

GROUND LEVEL

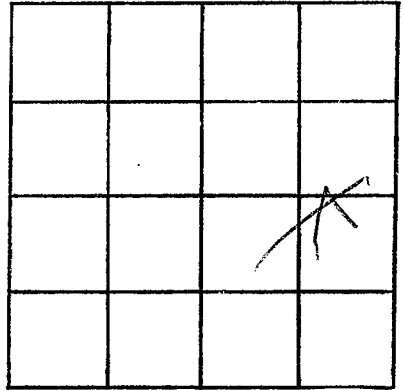

SECTION 24

Please indicate well location X.

ADDITIONAL INFORMATION

If more than one screen,  
show locations of each on sketch.