

**MISSISSIPPI
BOARD OF WATER COMMISSIONERS**
416 North State Street
Jackson, Mississippi 39201

WATER WELL DRILLERS LOG

Walthall
F50
1-17-70

Jan 17 1970 *Beenswell Pump* *Walthall*
date well completed firm name county well located

LANDOWNER: *John Smith*
Smiths
PO - Tybertown
(mailing address)

description of formations encountered	from	to
<i>Red clay</i>	<i>0</i>	<i>8</i>
<i>Chalk</i>	<i>8</i>	<i>12</i>
<i>chalky sand</i>	<i>12</i>	<i>20</i>
<i>sand</i>	<i>20</i>	<i>42</i>
<i>pea gravel sand</i>	<i>42</i>	<i>60</i>
<i>Red gravel</i>	<i>60</i>	<i>87</i>
<i>Chalky sand</i>	<i>87</i>	<i>135</i>
<i>Small gravel sand</i>	<i>135</i>	<i>140</i>

WELL LOCATION:
sec. *26* T. *2* N. R. *4* E
4 1/2 miles *E* of *Tybertown*
(distance) (direction) (nearest town)

WELL PURPOSE: *Home*
(home, irrigation, municipal, industrial)

WELL COMPLETION DATA:

- (1) diameter (inches) *4"*
- (2) total depth (feet) *140*
- (3) static water level (feet) *98* below above top of ground.
- (4) casing *Plastic Galvan*
(material) (depth)
- (5) screen *6'* *130'*
(length) (depth to top)
4" *Plastic*
(size) (material)
- (6) pump *Edgett Pump*
(HP) (yield gpm)
Electric
(type power)
- (7) electric log *NO*
(yes or no)

(organization running log)

(8) how well bottom plugged *wood plug*


MAR 23 1970

DRILLERS REMARKS: *all well bot.*

MISS. BD. OF
WATER COMMISSIONERS

If well telescopes please
sketch and show depths.

GROUND LEVEL

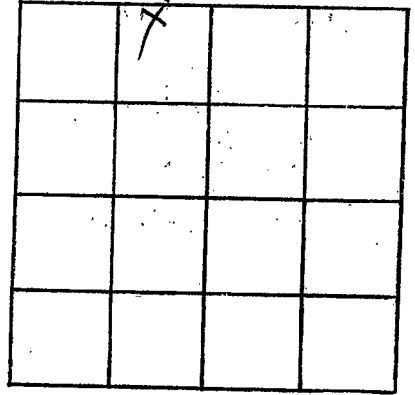

SECTION 26

Please indicate well location X.

ADDITIONAL INFORMATION

If more than one screen,
show locations of each on sketch.