

WANTHALL

F 51

8-17-70

MISSISSIPPI  
 BOARD OF WATER COMMISSIONERS  
 416 North State Street  
 Jackson, Mississippi 39201

**CODED**

WATER WELL DRILLERS LOG

8-17-70 19  
date well completed

*Figueroa well*  
firm name

*Walthall*  
county well located

LANDOWNER:

*Pinky Lowman*

*P.R. Figueroa, Inc.*  
(mailing address)

WELL LOCATION:

sec. 20 T. 20 N. R. 11 E.  
2 miles E of Felton  
(distance) (direction) (nearest town)

WELL PURPOSE: Flow  
(home, irrigation, municipal, industrial)

WELL COMPLETION DATA:

- (1) diameter (inches) 1 1/2
- (2) total depth (feet) 170
- (3) static water level (feet) 97 1/2 below above top of ground.
- (4) casing Plastic 134  
(material) (depth)  
4 if telescope see back.  
(size)
- (5) screen 6 134  
(length) (depth to top)  
4 (size) Plastic (material)
- (6) pump 1 1/2 10  
(HP) (yield gpm)  
Elco  
(type power)
- (7) electric log yes  
(yes or no)
- (8) how well bottom plugged Wood peg

description of formations encountered

from to

<i>Red Clay</i>	<i>0</i>	<i>20</i>
<i>Red Gravel</i>	<i>70</i>	<i>60</i>
<i>Red Sand</i>	<i>60</i>	<i>130</i>
<i>Coarse Sand &amp; Gravel</i>	<i>130</i>	<i>140</i>


**CODED**

DRILLERS REMARKS:

SEP 14 1970

If well telescopes please sketch and show depths.

GROUND LEVEL

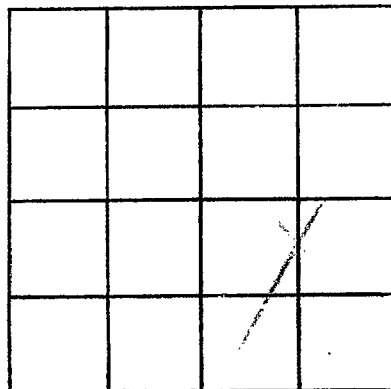

SECTION 20

Please indicate well location X.

ADDITIONAL INFORMATION

If more than one screen,  
show locations of each on sketch.