

WALTHALL
 F 52
 9-8-70

MISSISSIPPI
 BOARD OF WATER COMMISSIONERS
 416 North State Street
 Jackson, Mississippi 39201

CODED

WATER WELL DRILLERS LOG

9-8 1970 Fitzgerald Walthall
 date well completed firm name county well located

LANDOWNER:
Fate Summers
RR- Tylahoma, Miss
 (mailing address)

description of formations encountered	from	to
<u>Red clay</u>	<u>0</u>	<u>20</u>
<u>Fine Red sand</u>	<u>20</u>	<u>150</u>
<u>Coarse sand</u>	<u>150</u>	<u>162</u>

WELL LOCATION:
 sec. 18 T. 2 N. R. 11 E.
1 miles N of Tylahoma
 (distance) (direction) (nearest town)

WELL PURPOSE: Home
 (home, irrigation, municipal, industrial)

- WELL COMPLETION DATA:
- (1) diameter (inches) 4
 - (2) total depth (feet) 162
 - (3) static water level (feet) 30 ~~above~~ below top of ground.
 - (4) casing plastic, 154
 (material) (depth)
4 if telescope see back.
 (size)
 - (5) screen 8, 154
 (length) (depth to top)
4, plastic
 (size) (material)
 - (6) pump 1/2, 12
 (HP) (yield gpm)
electric
 (type power)
 - (7) electric log No
 (yes or/no)
 - (organization running log)
 - (8) how well bottom plugged wood


CODED

DRILLERS REMARKS:

SEP 14 1970

If well telescopes please sketch and show depths.

GROUND LEVEL

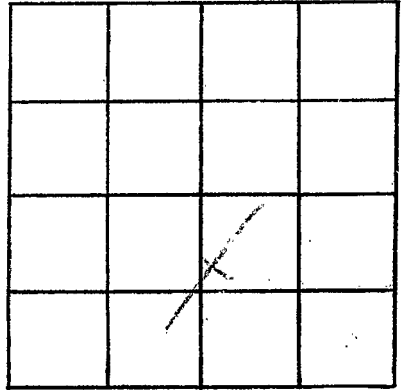

SECTION 18

Please indicate well location X.

ADDITIONAL INFORMATION

If more than one screen, show locations of each on sketch.