

Walthall
F 53
6-8-70

MISSISSIPPI
 BOARD OF WATER COMMISSIONERS
 416 North State Street
 Jackson, Mississippi 39201

CODED

WATER WELL DRILLERS LOG

6-8 19 70 Fitzgerald W. Walthall
 date well completed firm name county well located

LANDOWNER:
Mason May
R.R. Tylston Min.
 (mailing address)

description of formations encountered	from	to
<u>Red clay</u>	<u>0</u>	<u>20</u>
<u>Red sand</u>	<u>20</u>	<u>80</u>
<u>Blue clay</u>	<u>80</u>	<u>130</u>
<u>fine sand</u>	<u>130</u>	<u>140</u>
<u>Coarse sand</u>	<u>140</u>	<u>155</u>

WELL LOCATION:
 sec. 7 T. 2 N. R. 11 E.
4 miles NE of Tylston
 (distance) (direction) (nearest town)

WELL PURPOSE: Flow
 (home, irrigation, municipal, industrial)

WELL COMPLETION DATA:
 (1) diameter (inches) 4
 (2) total depth (feet) 155
 (3) static water level (feet) 75 below top of ground.
 (4) casing Galv., 147 below top of ground.
 (material) (depth)
4 if telescope see back.
 (size)
 (5) screen 8, 147 below top of ground.
 (length) (depth to top)
4, Plastic
 (size) (material)
 (6) pump 1/2, 10 below top of ground.
 (HP) (yield gpm)
90
 (type power)
 (7) electric log no
 (yes or no)
 (organization running log)

CODED


JUN 29 1970

(8) how well bottom plugged completely
 DRILLERS REMARKS:

MISS. BD. OF
 WATER COMM.

If well telescopes please sketch and show depths.

GROUND LEVEL

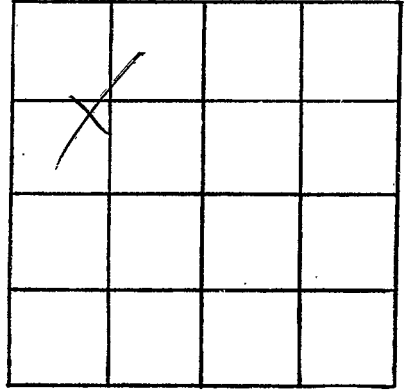

SECTION

7

Please indicate well location X.

ADDITIONAL INFORMATION

If more than one screen,
show locations of each on sketch.