

WALTHALL  
 F55  
 9-15-70

MISSISSIPPI  
 BOARD OF WATER COMMISSIONERS  
 416 North State Street  
 Jackson, Mississippi 39201

**CODED**

WATER WELL DRILLERS LOG

9-15 1970 Fleming Well Co Walthall  
 date well completed firm name county well located

LANDOWNER:

Dillon Hill Church  
R.R. Tylertown Miss.  
 (mailing address)

description of formations encountered

from to

<u>Red clay</u>	<u>0</u>	<u>15</u>
<u>Red sand to ground</u>	<u>15</u>	<u>90</u>
<u>Red sand</u>	<u>90</u>	<u>115</u>
<u>Coarse sand</u>	<u>115</u>	<u>129</u>

WELL LOCATION:

sec. 17 T. 20 N. R. 11 E.  
S W  
3 miles ENE of Tylertown  
 (distance) (direction) (nearest town)

WELL PURPOSE:

(home, irrigation, municipal, industrial)

WELL COMPLETION DATA:

- (1) diameter (inches) 4
- (2) total depth (feet) 129
- (3) static water level (feet) 90 below top of ground.
- (4) casing plastic, 121,  
 (material) (depth)  
4 if telescope see back.  
 (size)
- (5) screen 8, 121  
 (length) (depth to top)  
4, plastic  
 (size) (material)
- (6) pump 1/2, 8  
 (HP) (yield gpm)  
Elc  
 (type power)
- (7) electric log no  
 (yes or no)  
Elc  
 (organization running log)
- (8) how well bottom plugged completely

**CODED**


OCT 16 1970

MISS. Bd. of  
 WATER COMMISSIONERS

DRILLERS REMARKS:

If well telescopes please sketch and show depths.

GROUND LEVEL

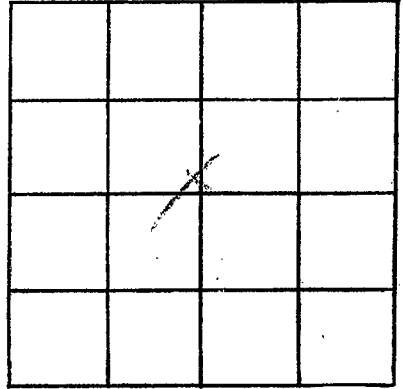

SECTION 17

Please indicate well location X.

ADDITIONAL INFORMATION

If more than one screen, show locations of each on sketch.