

WALTHALL
F56
9-16-70

MISSISSIPPI
BOARD OF WATER COMMISSIONERS
416 North State Street
Jackson, Mississippi 39201

CODED

WATER WELL DRILLERS LOG

Sept 16 1970 *Fitzgerald Well Co* *Walthall*
date well completed firm name county well located

LANDOWNER:

Kimberly Smith

R.R. Cylston Stn -
(mailing address)

WELL LOCATION:

sec. 33 T. 2 N. R. 11 E.
S

2 1/2 miles SE of Fulton
(distance) (direction) (nearest town)

WELL PURPOSE:

Home
(home, irrigation, municipal, industrial)

WELL COMPLETION DATA:

- (1) diameter (inches) 4
- (2) total depth (feet) 68
- (3) static water level (feet) 70 below top of ground.
- (4) casing plastic, 62,
(material) (depth)
4 if telescope see back.
(size)
- (5) screen 6, 62
(length) (depth to top)
4, plastic
(size) (material)
- (6) pump 1/2, 5
(HP) (yield gpm)
elm
(type power)
- (7) electric log no
(yes or no)
(organization running log)
- (8) how well bottom plugged steel pt

description of formations encountered

from to

<i>red clay</i>	<i>0</i>	<i>10</i>
<i>red silt</i>	<i>10</i>	<i>40</i>
<i>red sand</i>	<i>40</i>	<i>60</i>
<i>concrete sand</i>	<i>60</i>	<i>68</i>

CODED


OCT 16 1970

MISS. BD. OF
WATER COM. 2

DRILLERS REMARKS:

If well telescopes please sketch and show depths.

GROUND LEVEL

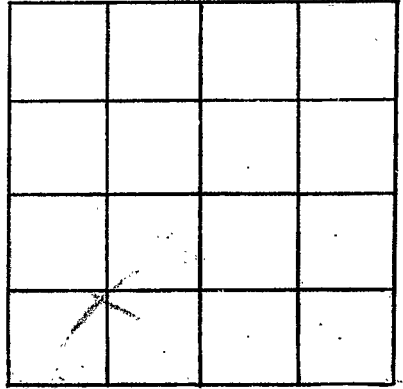

SECTION 33

Please indicate well location X.

ADDITIONAL INFORMATION

If more than one screen,
show locations of each on sketch.