

WALTHALL
F 57

10-7-70

10-7
date well completed

1970

MISSISSIPPI
BOARD OF WATER COMMISSIONERS
416 North State Street
Jackson, Mississippi 39201

CODED

WATER WELL DRILLERS LOG

Fitzgerald Wells
firm name

Walthall
county well located

LANDOWNER:

Ellis - Brumfield
P.R. Tylentown
(mailing address)

description of formations
encountered

from to

Red clay 0 28
Red sand 20 90
Coarse sand 75 111

WELL LOCATION:

sec. 27 T 20 N R 11 E
4 miles E of Tylentown
(distance) (direction) (nearest town)

WELL PURPOSE: Home
(home, irrigation, municipal, industrial)

WELL COMPLETION DATA:

- (1) diameter (inches) 4
- (2) total depth (feet) 111
- (3) static water level (feet) 80 below top of ground.
- (4) casing plastic 10.5
(material) (depth)
4 (size) if telescope see back.
- (5) screen 6 10.5
(length) (depth to top)
4 (size) plastic (material)
- (6) pump 1/2 7
(HP) (yield gpm)
alt (type power)
- (7) electric log no
(yes or no)
(organization running log)
- (8) how well bottom plugged weary

CODED


OCT 16 1970

DRILLERS REMARKS:

MISS. BD. OF
WATER COMM.

If well telescopes please sketch and show depths.

GROUND LEVEL

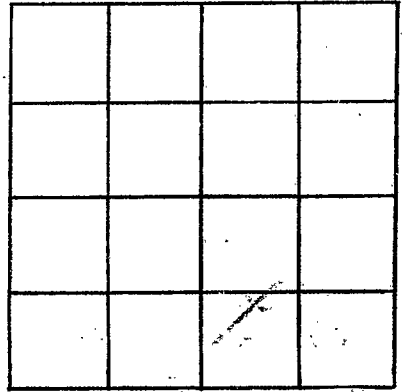

SECTION 27

Please indicate well location X.

ADDITIONAL INFORMATION

If more than one screen, show locations of each on sketch.