

MISSISSIPPI
BOARD OF WATER COMMISSIONERS
416 North State Street
Jackson, Mississippi 39201

CODED

WATER WELL DRILLERS LOG

Walthall
F58
3-67

3-8-1967 *Ergebnis Water Service Walthall*
date well completed firm name county well located

LANDOWNER: *MA Baird*
Tylertown Rt Miss

description of formations encountered	from	to
<i>Top Soil & Clay</i>	<i>0</i>	<i>35</i>
<i>Heavy Gravel</i>	<i>35</i>	<i>55</i>
<i>Red Chalk</i>	<i>55</i>	<i>65</i>
<i>Sand</i>	<i>65</i>	<i>85</i>
<i>Coarse Sand & Gravel</i>	<i>85</i>	<i>100</i>

(mailing address)

WELL LOCATION:


sec *26* T *2* N R *11* E
S W
8 miles *E* of *Tylertown*
(distance) (direction) (nearest town)

WELL PURPOSE: *Home*
(home, irrigation, municipal, industrial)

WELL COMPLETION DATA:

- (1) diameter (inches) *4*
- (2) total depth (feet) *100*
- (3) static water level (feet) *55* below top of ground.
- (4) casing *plastic*, *92'* (material), (depth)
4 (size) if telescope see back.
- (5) screen *8ft*, *92'* (length), (depth to top)
4 (size), *plastic* (material)
- (6) pump *1 Jet - 10* (HP), (yield gpm)
3hp (type power)
- (7) electric log *no* (yes or no)
(organization running log)
- (8) how well bottom plugged *Ward Reg*


CODED

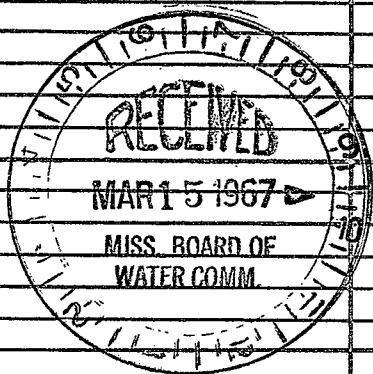

DRILLERS REMARKS:

If well telescopes please sketch and show depths.

GROUND LEVEL

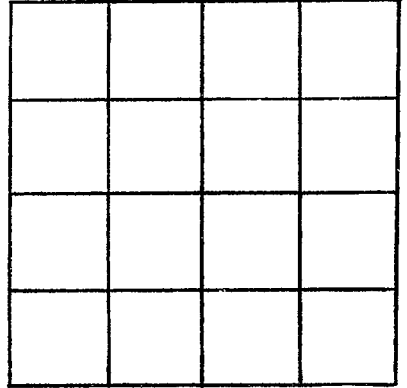

SECTION _____

Please indicate well location X.

ADDITIONAL INFORMATION

If more than one screen, show locations of each on sketch.