

MISSISSIPPI
BOARD OF WATER COMMISSIONERS
416 North State Street
Jackson, Mississippi 39201

CODED

WATER WELL DRILLERS LOG

WALTHALL
F 60
2-23-71

2-23
date well completed

1971

Fitzgerald well
firm name

walthall
county well located

LANDOWNER:

J. R. Linder

R. H. Tylton
(mailing address)

WELL LOCATION:

sec. 24 T. 20 S. R. 11 E. W.
1 miles S of Knox
(distance) (direction) (nearest town)

WELL PURPOSE:

(home, irrigation, municipal, industrial)

WELL COMPLETION DATA:

- (1) diameter (inches) 4
- (2) total depth (feet) 142
- (3) static water level (feet) 105 below top of ground.
- (4) casing Plaster 134 (material) (depth)
- 4 (size) if telescope see back.
- (5) screen 8 (length) 134 (depth to top)
- 4 (size) Plaster (material)
- (6) pump 1 1/2 (HP) 10 (yield gpm)
- alt (type power)
- (7) electric log no (yes or no)
- (organization running log)
- (8) how well bottom plugged completely

description of formations encountered

from to

Red clay	0	20
Red sand	20	30
Red gravel	30	110
Red loam	110	130
Coarse loam & gravel	130	142

CODED


MAR 5 - 1971

DRILLERS REMARKS:

MISS. BD. OF
WATER COMMISSIONERS

If well telescopes please
sketch and show depths.

GROUND LEVEL

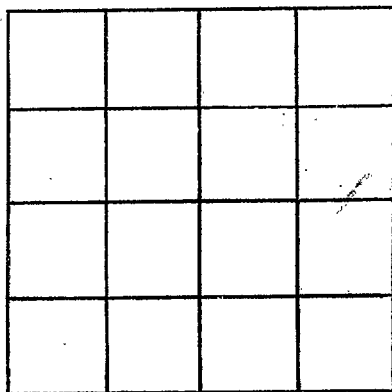

SECTION _____

Please indicate well location X.

ADDITIONAL INFORMATION

If more than one screen,
show locations of each on sketch.