

WALTHALL
F61
2-71

MISSISSIPPI
BOARD OF WATER COMMISSIONERS
416 North State Street
Jackson, Mississippi 39201

WATER WELL DRILLERS LOG

CODED

FEB. 1971
date well completed

E. B. SHERROD
firm name

WALTHALL
county well located

LANDOWNER:

L. V. ANDREWS

TYLERTOWN, MISS.
(mailing address)

description of formations encountered

LOOSE SANDY
BED CLAY
GRAVEL TURNING
TO FINE GRAVEL +
COARSE SAND

from

to

0 70'
70' 138'

WELL LOCATION:

sec 24 T 2 N R 11 E
S W
5 miles E of TYLERTOWN
(distance) (direction) (nearest town)

WELL PURPOSE:

Home, irrigation, municipal, industrial

WELL COMPLETION DATA:

- (1) diameter (inches) 2"
- (2) total depth (feet) 138'
- (3) static water level (feet) 60 below top of ground.
- (4) casing PL, 133 (material) (depth)
2" (size) if telescope see back.
- (5) screen 5' (length) (depth to top)
2" (size) PL (material)
- (6) pump 8 (HP) (yield gpm)
E (type power)
- (7) electric log (yes or no)
- (organization running log)
- (8) how well bottom plugged B/W

CODED


MAY 27 1971

MISS. BD. OF
WATER COMMISSIONERS

DRILLERS REMARKS:

If well telescopes please sketch and show depths.

GROUND LEVEL

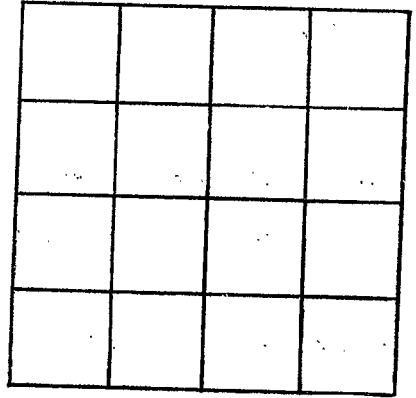

SECTION _____

Please indicate well location X.

ADDITIONAL INFORMATION

If more than one screen,
show locations of each on sketch.