

WALTHALL
F63
9-27-71

MISSISSIPPI
 BOARD OF WATER COMMISSIONERS
 416 North State Street
 Jackson, Mississippi 39201

CODED

WATER WELL DRILLERS LOG

9-27 1971 Fitzgerald Well Inc Walthall
 date well completed firm name county well located

LANDOWNER:	description of formations encountered	from	to
<u>A. Magee</u>			
<u>R.R. Tylston</u> (mailing address)	<u>Red sand</u>	<u>20</u>	<u>20</u>
WELL LOCATION:	<u>Coarse sand</u>	<u>40</u>	<u>95</u>
sec. <u>21</u> T. <u>2</u> N. R. <u>11</u> E	<u>Fine sand</u>	<u>95</u>	<u>155</u>
<u>1</u> miles <u>E</u> of <u>Tylston</u> (distance) (direction) (nearest town)	<u>Coarse sand</u>	<u>130</u>	<u>146</u>
WELL PURPOSE: <u>Home</u> (home, irrigation, municipal, industrial)			
WELL COMPLETION DATA:			
(1) diameter (inches) <u>4</u>			
(2) total depth (feet) <u>146</u>			
(3) static water level (feet) <u>80</u> below above top of ground.			
(4) casing <u>plastic</u> , <u>140</u> , (material) (depth) <u>4</u> if telescope see back. (size)			
(5) screen <u>6</u> , <u>140</u> (length) (depth to top) <u>4</u> , <u>plastic</u> (size) (material)			
(6) pump <u>1/2</u> , <u>6</u> (HP) (yield gpm) <u>ELC</u> (type power)			
(7) electric log <u>no</u> (yes or no) (organization running log)			
(8) how well bottom plugged <u>wood pg</u>			
DRILLERS REMARKS:			


CODED

OCT 28 1971

MISS. BD. OF
 WATER COMMISSIONERS

If well telescopes please sketch and show depths.

GROUND LEVEL

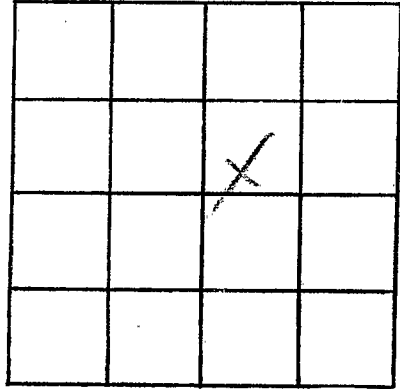

SECTION 21

Please indicate well location X.

ADDITIONAL INFORMATION

A series of horizontal lines for writing additional information, starting below the 'ADDITIONAL INFORMATION' header and extending down to the bottom of the page.

If more than one screen, show locations of each on sketch.