

WALTHALL  
F66  
9-71

MISSISSIPPI  
BOARD OF WATER COMMISSIONERS  
416 North State Street  
Jackson, Mississippi 39201  
WATER WELL DRILLERS LOG

SEPT. 1971 F. B. SHEPPARD  
date well completed firm name

COPIED  
could be well located

LANDOWNER: LESUE MARK  
Rt. 2 TYLERTOWN  
(mailing address)

description of formations encountered	from	to
SANDY RED CLAY	0	60'
STRAITS CLAY	60'	90'
COARSE GRAVEL	90'	140'
REA GRAVEL & SAND	140'	160'

WELL LOCATION:  
sec. 11 T 2 N R 11 E  
S W  
5 miles E.N.E. of TYLERTOWN  
(distance) (direction) (nearest town)

WELL PURPOSE:  
(home, irrigation, municipal, industrial)

- WELL COMPLETION DATA:
- (1) diameter (inches) 2"
  - (2) total depth (feet) 160
  - (3) static water level (feet) 95 below above top of ground.
  - (4) casing PL, 155 (material) (depth)  
2" (size) if telescope see back.
  - (5) screen 5' (length) (depth to top)  
2" (size) PL (material)
  - (6) pump 1/2 (HP) 8 (yield gpm)  
E (type power)
  - (7) electric log (yes or no)
  - (organization running log)
  - (8) how well bottom plugged BWV

CODED


FEB - 9 1972

DRILLERS REMARKS:

MISS. Bd. of  
WATER COMMISSIONERS

If well telescopes please sketch and show depths.

GROUND LEVEL

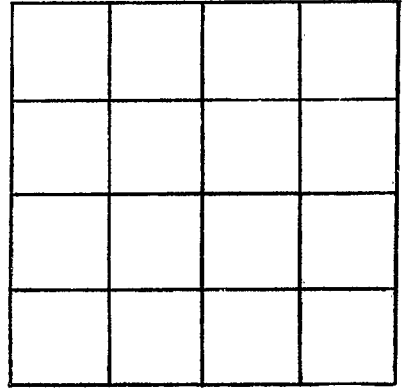

SECTION \_\_\_\_\_

Please indicate well location X.

ADDITIONAL INFORMATION

If more than one screen,  
show locations of each on sketch.