

WALTHALL
 F 67
 1-12-72

MISSISSIPPI
 BOARD OF WATER COMMISSIONERS
 416 North State Street
 Jackson, Mississippi 39201

CODED

FD - 7 1972

WATERWELL DRILLERS LOG

Jan 12 1972 Chestertown Walthall
 date well completed firm name county well located

LANDOWNER: R.T. Beard
 RFD 1
 Tyler town
 (mailing address)

description of formations encountered	from	to
clay gravel	0	17
red chalk	17	40
sand & small gravel	40	54
white chalk	54	93
gravel & coarse sand	93	101

WELL LOCATION:
 sec. 6 T. 2 N. R. 11 E
 3 miles W of Tyler town
 (distance) (direction) (nearest town)

WELL PURPOSE: Home
 (home, irrigation, municipal, industrial)

WELL COMPLETION DATA:

(1) diameter (inches) 4"

(2) total depth (feet) 101

(3) static water level (feet) 43 below top of ground

(4) casing: Plast Balltown (material) (depth)
 (size) If telescope see back.

(5) screen: 6' 9.5' (length) (depth to top)
 4" Plast (size) (material)

(6) pump: owners' old (HP) (field gpm)
 pump (type power)

(7) electric log: No (yes or no)

(organization running log)


CODED

(8) how well bottom plugged: working plug

DRILLERS REMARKS: well had

If well telescopes please sketch and show depths.

GROUND LEVEL

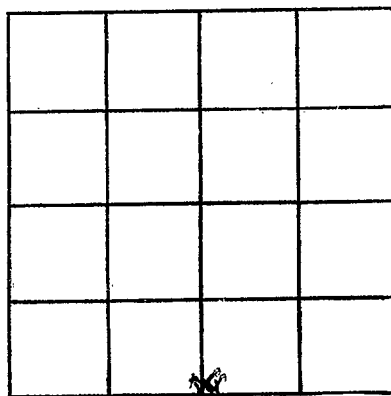

SECTION 6

Please indicate well location X.

ADDITIONAL INFORMATION

If more than one screen, show locations of each on sketch.