

WALTHALL  
F 70  
3-28-72

MISSISSIPPI  
BOARD OF WATER COMMISSIONERS  
416 North State Street  
Jackson, Mississippi 39201

WATER WELL DRILLERS LOG

March 28 1972 Chestnut Hill Walthall  
Date well completed firm name county well located

LANDOWNER: Canway  
Hammann  
Rt-2 Tylertown  
(mailing address)

| description of formations encountered | from | to  |
|---------------------------------------|------|-----|
| Red Clay                              | 0    | 17  |
| Red Sand                              | 17   | 62  |
| Sand & gravel                         | 62   | 96  |
| with shark mired with sand & gravel   | 96   | 152 |
| Small gravel & sand                   | 152  | 166 |

WELL LOCATION:  
sec. 24 T. 2 N. R. 11 E  
3 miles E of Tylertown  
(distance) (direction) (nearest town)

WELL PURPOSE: Farm  
(home, irrigation, municipal, industrial)

WELL COMPLETION DATA:

- (1) diameter (inches) 4"
- (2) total depth (feet) 166
- (3) static water level (feet) 95 below top of ground.
- (4) casing Plast Bottom  
(material) (depth)
- (size) if telescope see back.
- (5) screen 6' 166'  
(length) (depth to top)
- 4" Plast  
(size) (material)
- (6) pump 1/2 HP 12  
(HP) (yield gpm)
- Electric  
(type power)
- (7) electric log No  
(yes or no)
- (organization running log)


(8) how well bottom plugged  
wood plug

DRILLERS REMARKS:  
New house.

AREA 3 1972  
ENGS. ID. OF WATER COMM

If well telescopes please sketch and show depths.

GROUND LEVEL

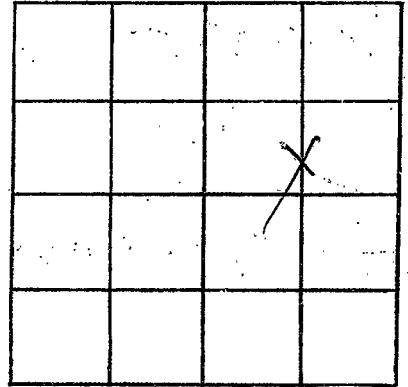

SECTION 24

Please indicate well location X.

ADDITIONAL INFORMATION

If more than one screen, show locations of each on sketch.