

WALTHALL
F 71
3-72

MISSISSIPPI
 BOARD OF WATER COMMISSIONERS
 416 North State Street
 Jackson, Mississippi 39201

CODED

WATER WELL DRILLERS LOG

March 1972 E.B. Sheppard Walthall
 date well completed firm name county well located

LANDOWNER:

Lillie Mae Smith
Jaylorton, Miss
 (mailing address)

description of formations encountered

from to

RED SANDY
GRAVEL CLAY 0 120
GRAVEL & SAND 120 142

WELL LOCATION:

sec. 1 T 2 N R 11 E
 S W
5 1/2 miles NE Jaylorton
 (distance) (direction) (nearest town)

WELL PURPOSE:

(home) Irrigation, municipal, industrial

WELL COMPLETION DATA:

- (1) diameter (inches) 2"
- (2) total depth (feet) 142
- (3) static water level (feet) 76 below above top of ground.
- (4) casing pl. 137
 (material) (depth)
2" If telescope see back.
 (size)
- (5) screen 5' pl.
 (length) (depth to top)
2" pl.
 (size) (material)
- (6) pump 1 7
 (HP) (yield gpm)
E
 (type power)
- (7) electric log (yes or no)
 (organization running log)
- (8) how well bottom plugged Brw


CODED

JUL 26 1972


MISS. Bd. OF
 WATER COMM.

DRILLERS REMARKS:

If well telescopes please sketch and show depths.

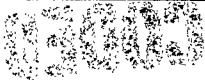

GROUND LEVEL

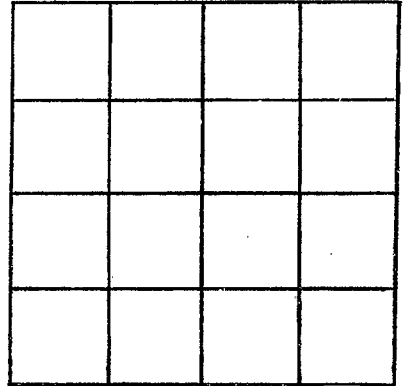

SECTION _____

Please indicate well location X.

ADDITIONAL INFORMATION

A series of horizontal lines provided for entering additional information, with approximately 25 lines available for text entry.

If more than one screen, show locations of each on sketch.