

WALTHALL
F73
8-2-72

MISSISSIPPI
BOARD OF WATER COMMISSIONERS
416 North State Street
Jackson, Mississippi 39201

CODED

WATER WELL DRILLERS LOG

Aug 2 1972 Chatterboxes Walthall
date well completed firm name county well located

LANDOWNER: Bill
Mr. E. H. Hagan
RT-1, Tylertown
(mailing address)

WELL LOCATION:
sec. 19 T. 2 N. R. 11 E
1/2 miles ENE of Tylertown
(distance) (direction) (nearest town)

WELL PURPOSE: Lake
(home, irrigation, municipal, industrial)

WELL COMPLETION DATA:

- (1) diameter (inches) 4"
- (2) total depth (feet) 300
- (3) static water level (feet) 20 below above top of ground.
- (4) casing Plastic Ballou
(material) (depth)
- _____ if telescope see back.
(size)
- (5) screen 20', 280'
(length) (depth to top)
4", Plastic
(size) (material)
- (6) pump None 75
(HP) (yield gpm)
Artesian
(type power)
- (7) electric log NO
(yes or no)
- _____ (organization running log)
- (8) how well bottom plugged wooden plug

description of formations encountered	from	to
clay	0	16
gray sand	16	28
white sand	28	74
white sand	74	77
blue shale	77	235
fine blue sand	235	280
coarse sand	280	300

CODED


DEC 1 1972

MISS. Bd. of
WATER COMMISSIONERS

DRILLERS REMARKS: Fresh water for fish in lake.

If well telescopes please sketch and show depths.

GROUND LEVEL

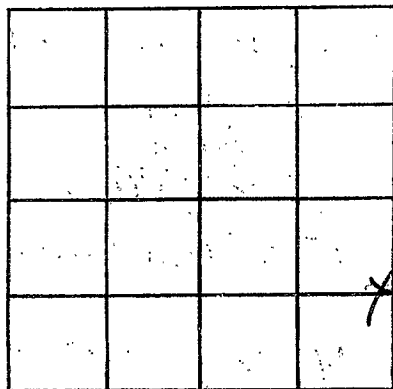

SECTION 19

Please indicate well location X.

ADDITIONAL INFORMATION

If more than one screen,
show locations of each on sketch.