

WALTHALL
F 76
3-27-73

MISSISSIPPI
 BOARD OF WATER COMMISSIONERS
 416 North State Street
 Jackson, Mississippi 39201

CODED

WATER WELL DRILLERS LOG

3-27 1973 Hydrus Well Serv Walthall
 date well completed firm name county well located

LANDOWNER:
Dale Bull
P.R. Fyfe town Miss.
 (mailing address)

description of formations encountered	from	to
<u>Red clay</u>	<u>0</u>	<u>20</u>
<u>Red sand</u>	<u>20</u>	<u>90</u>
<u>White clay</u>	<u>90</u>	<u>115</u>
<u>Coarse sand & gravel</u>	<u>115</u>	<u>130</u>

WELL LOCATION:
 sec. 23 T. 2N S. R. 11E
3 miles E of Fyfe town
 (distance) (direction) (nearest town)

WELL PURPOSE:
 (home, irrigation, municipal, industrial)

- WELL COMPLETION DATA:
- (1) diameter (inches) 4
 - (2) total depth (feet) 130
 - (3) static water level (feet) 80 below above top of ground.
 - (4) casing plastic, 122,
 (material) (depth)
4 if telescope see back.
 (size)
 - (5) screen 8, 122
 (length) (depth to top)
4, plastic
 (size) (material)
 - (6) pump 1, 4
 (HP) (yield gpm)
elec
 (type power)
 - (7) electric log ny
 (yes or no)
 (organization running log)
 - (8) how well bottom plugged covered peg


CODED

DRILLERS REMARKS:

APR 8 1973

If well telescopes please sketch and show depths.

GROUND LEVEL

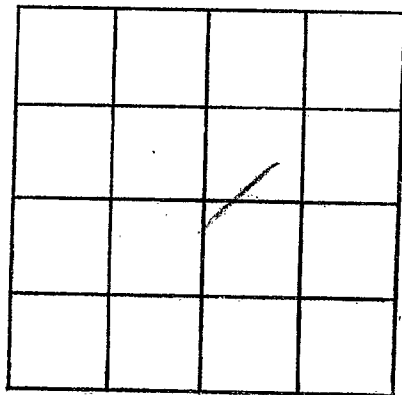

SECTION 73

Please indicate well location X.

ADDITIONAL INFORMATION

If more than one screen,
show locations of each on sketch.