

WALTHALL

F 77

3-9-73

MISSISSIPPI BOARD OF WATER COMMISSIONERS 416 North State Street Jackson, Mississippi 39201

CODED

WATER WELL DRILLERS LOG

March 9 1973 Chester Keener Walthall date well completed firm name county well located

LANDOWNER: Escal Jacobs RFD - Tybertown (mailing address)

Table with 3 columns: description of formations encountered, from, to. Rows include: clay (0-17), red sand (17-122), gravel & sand (122-127), loblolly sand (127-161), sand & gravel (161-168), chack & sand (168-200), coarse sand & pea gravel (200-215).

WELL LOCATION: sec 13 T 2 N R 11 E at Krippe - 1/2 north (distance) (direction) (nearest town)

WELL PURPOSE: Home (home, irrigation, municipal, industrial)

- WELL COMPLETION DATA: (1) diameter (inches) 4" (2) total depth (feet) 215 (3) static water level (feet) 73 below top of ground. (4) casing Plast Bottom (material) (depth) (size) if telescope see back. (5) screen 6' 209 (length) (depth to top) 4" Plast (size) (material) (6) pump 1/2 Sub 12 (HP) (yield gpm) Plast (type power) (7) electric log NO (yes or no) (organization running log) (8) how well bottom plugged wood plug


CODED

DRILLERS REMARKS: New house

JUN 5 1973

If well tele. . . .  
sketch and screen depths.

GROUND LEVEL

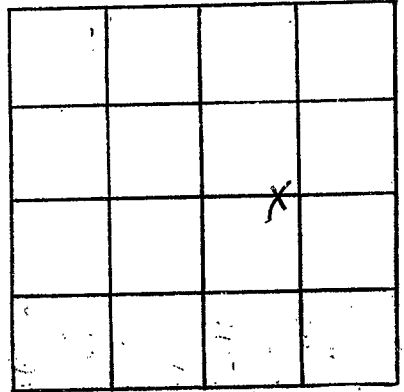

SECTION 13

Please indicate well location X.

ADDITIONAL INFORMATION

If more than one screen,  
show locations of each on sketch.