

WALTHALL
F 79
11-20-73

MISSISSIPPI
BOARD OF WATER COMMISSIONERS
416 North State Street
Jackson, Mississippi 39201

WATER WELL DRILLERS LOG

CODED

11/20 1973 Griner-Gunn Walthall
date well completed firm name county well located

LANDOWNER:
W. H. Andrews
Kokomo, Miss.
(mailing address)

description of formations encountered	from	to
<u>Gravel</u>	<u>0</u>	<u>1</u>
<u>Clay + Gravel</u>	<u>1</u>	<u>15</u>
<u>Chalk</u>	<u>15</u>	<u>65</u>
<u>Sand</u>	<u>65</u>	<u>90</u>

WELL LOCATION:
sec. 6 T. 2 N. R. 11 E.
3 miles SW of Kokomo
(distance) (direction) (nearest town)

WELL PURPOSE: Home
(home, irrigation, municipal, industrial)

- WELL COMPLETION DATA:
- (1) diameter (inches) 4
 - (2) total depth (feet) 90
 - (3) static water level (feet) 50 below above top of ground
 - (4) casing Plastic 80
(material) (depth)
 - (size) if telescope see back.
 - (5) screen 10 ft 80 ft
(length) (depth to top)
 - (size) 4 (material) plastic
 - (6) pump 3/11 Stage 10
(HP) (yield gpm)
 - (type power) Elec
 - (7) electric log _____
(yes or no)
 - (organization running log) _____
 - (8) how well bottom plugged 1/2 W Valve


CODED

DRILLERS REMARKS:

NOV 26 1973

If well telescopes please sketch and show depths.

GROUND LEVEL

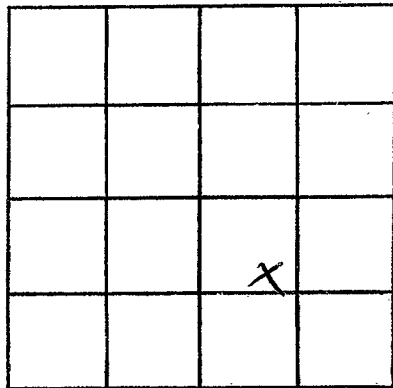

SECTION 6

Please indicate well location X.

ADDITIONAL INFORMATION

If more than one screen,
show locations of each on sketch.