

WALTHALL

F 80

7-17-73

MISSISSIPPI
 BOARD OF WATER COMMISSIONERS
 416 North State Street
 Jackson, Mississippi 39201

CODED

WATER WELL DRILLERS LOG

July 17 1973 Chester Keener Walthall
 date well completed firm name county well located

LANDOWNER: Maseel Foxworth
Rt 2, Tylertown
 (mailing address)

WELL LOCATION:
 sec. 12 T. 2 N. R. 11 E.
1 miles N of Keosauqua
 (distance) (direction) (nearest town)

WELL PURPOSE: Aerul.
 (home, irrigation, municipal, industrial)

WELL COMPLETION DATA:
 (1) diameter (inches) 4"
 (2) total depth (feet) 200
 (3) static water level (feet) 198 below top of ground.
 (4) casing Plast Galv
 (material) (depth)

(5) screen 6' 194'
 (length) (depth to top)
4" Plast
 (size) (material)

(6) pump 1/2 Sub 1 1/2
 (HP) (yield gpm)
Elect
 (type power)


(7) electric log NO
 (yes or no)
 (organization running log)

(8) how well bottom plugged
wood plug

description of formations encountered	from	to
Red clay	0	18
Sand & Chalk	18	96
Sand & gravel	96	122
gravel & chalk	122	162
Red gravel	162	170
pink chalk	170	178
Coarse white sand	178	200

CODED


DRILLERS REMARKS:
New house

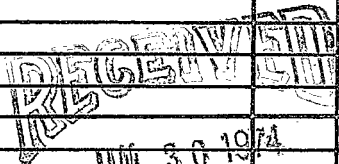

JUL 30 1974

If well telescopes please sketch and show depths.

GROUND LEVEL

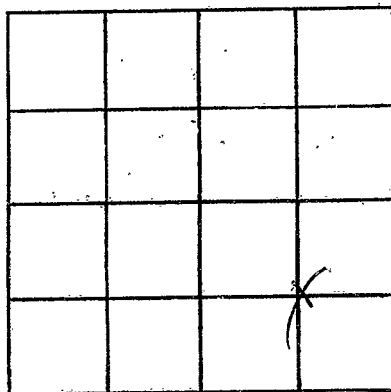

SECTION 12

Please indicate well location X.

ADDITIONAL INFORMATION

If more than one screen, show locations of each on sketch.