

WALTHALL  
F81  
10/4/74

MISSISSIPPI  
BOARD OF WATER COMMISSIONERS  
416 North State Street  
Jackson, Mississippi 39201

CODED

WATER WELL DRILLERS LOG

10-4  
date well completed

1974 *Flygull Well Service*  
firm name

*Walthall*  
county well located

LANDOWNER:  
*Hansley Brown*  
*R.R. Flygull*  
(mailing address)

description of formations encountered	from	to
<i>Red Clay</i>	<i>0</i>	<i>20</i>
<i>Red ground</i>	<i>20</i>	<i>25</i>
<i>white chalk</i>	<i>25</i>	<i>60</i>
<i>Coarse sand</i>	<i>60</i>	<i>70</i>

WELL LOCATION:  
sec. *2* T. *20* S. R. *11E*  
*2* miles *N* of *Flygull*  
(distance) (direction) (nearest town)

WELL PURPOSE:  
*Home*  
(home, irrigation, municipal, industrial)

- WELL COMPLETION DATA:
- (1) diameter (inches) *4*
  - (2) total depth (feet) *70*
  - (3) static water level (feet) *25* below top of ground.
  - (4) casing *plastic*, *62*,  
(material) (depth)  
*4* if telescope see back.  
(size)
  - (5) screen *8*, *62*,  
(length) (depth to top)  
*4*, *plastic*  
(size) (material)
  - (6) pump *1/3*, *5*  
(HP) (yield gpm)  
*elc*  
(type power)
  - (7) electric log *no*  
(yes or no)  
(organization running log)
  - (8) how well bottom plugged *Sand shak*

CODED




OCT 20 1974

DRILLERS REMARKS:

MISSISSIPPI WATER CO

If well telescopes please sketch and show depths.

GROUND LEVEL

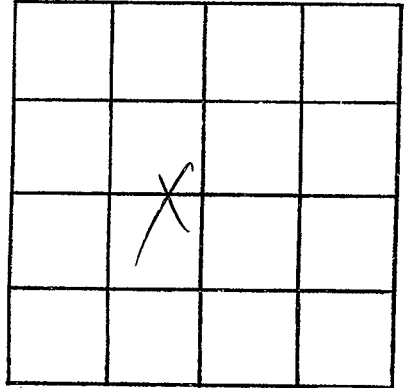

SECTION 7

Please indicate well location X.

ADDITIONAL INFORMATION

If more than one screen,  
show locations of each on sketch.