

WALTHALL
F82
1-23-75

MISSISSIPPI
BOARD OF WATER COMMISSIONERS
416 North State Street
Jackson, Mississippi 39201

CODED


WATER WELL DRILLERS LOG

1-23 1975 *Fitzgerald Hill Land* *walthall*
date well completed firm name county well located

LANDOWNER:	description of formations encountered	from	to
<i>State Gasoline</i>	<i>Red clay</i>	0	20
<i>RR. Lytleton</i> (mailing address)	<i>Red sand & gravel</i>	20	102
	<i>Coarse sand & gravel</i>	102	111
WELL LOCATION: sec. <u>1</u> T. <u>2</u> N. <u>2</u> S. R. <u>11</u> E. <u>W</u> <u>6</u> miles <u>E</u> of <u>Lytleton</u> (distance) (direction) (nearest town)			
WELL PURPOSE: <u>Home</u> (home, irrigation, municipal, industrial)			
WELL COMPLETION DATA: (1) diameter (inches) <u>4</u> (2) total depth (feet) <u>116</u> (3) static water level (feet) <u>80</u> below top of ground. (4) casing <u>Plastic, 108,</u> (material) (depth) <u>4</u> If telescope see back. (size) (5) screen <u>8, 108</u> (length) (depth to top) <u>4</u> , <u>plastic</u> (size) (material) (6) pump <u>1/2, 10</u> (HP) (yield gpm) <u>Electric</u> (type power) (7) electric log <u>Yes</u> (yes or no) (organization running log) (8) how well bottom plugged <u>Sand Shok</u>	<p>CODED</p>		
DRILLERS REMARKS:	<p>DECISION/STAMP</p> <p>FEB 10 1975</p> <p>MISS. Bd. OF WATER COM.</p>		

If well telescopes please sketch and show depths.

GROUND LEVEL

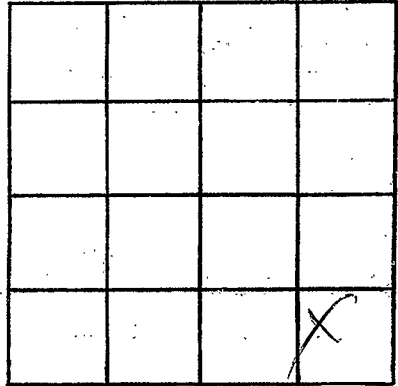

SECTION 1

Please indicate well location X.

ADDITIONAL INFORMATION

If more than one screen, show locations of each on sketch.