

WALTHALL
F83
3-30-74

MISSISSIPPI
BOARD OF WATER COMMISSIONERS
416 North State Street
Jackson, Mississippi 39201

CODED

WATER WELL DRILLERS LOG

March 30, 1974 Chester Keene Walthall
date well completed firm name county well located

LANDOWNER: R. Magee
Rt 2
Tylertown
(mailing address)

description of formations encountered	from	to
Red clay	0	18
Red sand	18	55
Sand & gravel	55	66
white chalk	66	108
Coarse sand & pea gravel	110	158

WELL LOCATION:
sec. 29 T 2 N R 11 E 130
1 miles east of Tylertown
(distance) (direction) (nearest town)

WELL PURPOSE: house
(home, irrigation, municipal, industrial)

- WELL COMPLETION DATA:
- (1) diameter (inches) 4"
 - (2) total depth (feet) 158
 - (3) static water level (feet) 61 below top of ground
 - (4) casing Asst. Ballon
(material) (depth)
(size) If telescope see back.
 - (5) screen 6' 152
(length) (depth to top)
1/2" Plast
(size) (material)
 - (6) pump 1/2 Sub 12
(HP) (yield gpm)
Elect
(type power)
 - (7) electric log no
(yes or no)

CODED

(organization running log)


(8) how well bottom plugged
wooden plug

DRILLERS REMARKS:
New house

DRIVER
LATE
FEB 12 1975
MISS. BD. OF WATER COMMISSIONERS

If well telescopes please sketch and show depths.

GROUND LEVEL

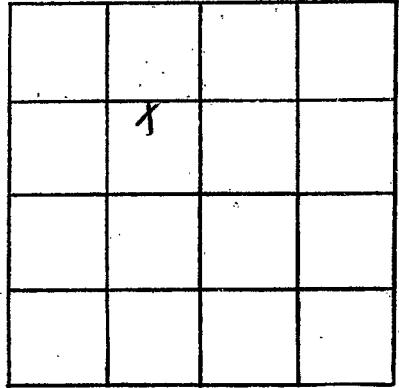

SECTION 29

Please indicate well location X.

ADDITIONAL INFORMATION

If more than one screen, show locations of each on sketch.