

WALTHALL  
F 84  
3-20-75

MISSISSIPPI  
BOARD OF WATER COMMISSIONERS  
416 North State Street  
Jackson, Mississippi 39201

CODED

WATER WELL DRILLERS LOG

3-20 1975 Fitzgerald Well Serv Walthall  
date well completed firm name county well located

LANDOWNER:	description of formations encountered	from	to
<u>Walter Lewis</u> <u>P.R. Lyle</u> (mailing address)			
WELL LOCATION: sec. <u>24</u> T. <u>2</u> N S R. <u>11</u> E <u>8</u> miles <u>E</u> of <u>Walthall</u> (distance) (direction) (nearest town)			
WELL PURPOSE: <u>Home</u> (home, irrigation, municipal, industrial)			
WELL COMPLETION DATA:			
(1) diameter (inches) <u>4</u>			
(2) total depth (feet) <u>156</u>			
(3) static water level (feet) <u>80</u> below above top of ground.			
(4) casing <u>plastic</u> , <u>148</u> , (material) (depth) <u>4</u> If telescope see back. (size)			
(5) screen <u>8</u> , <u>148</u> (length) (depth to top) <u>4</u> , <u>plastic</u> (size) (material)			
(6) pump <u>1/2</u> , <u>70</u> (HP) (yield gpm) <u>also</u> (type power)			
(7) electric log <u>no</u> (yes or no)  (organization running log)			
(8) how well bottom plugged <u>Sand shot</u>			


CODED

RECEIVED  
APR - 2 1975

DRILLERS REMARKS:

If well telescopes please sketch and show depths.

GROUND LEVEL

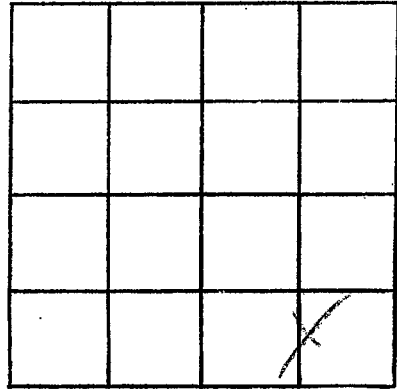

SECTION 27

Please indicate well location X.

ADDITIONAL INFORMATION

If more than one screen,  
show locations of each on sketch.