

WALTHALL
F 85
3-26-75

MISSISSIPPI
BOARD OF WATER COMMISSIONERS
416 North State Street
Jackson, Mississippi 39201

CODED

WATER WELL DRILLERS LOG

3-26 1975 Fitzgerald Walthall
date well completed firm name county well located

LANDOWNER:	description of formations encountered	from	to
<u>Randolph Clark</u>	<u>Red Clay</u>	0	20
<u>R.R. Fyfe</u> (mailing address)	<u>White & Blue Clay</u>	20	90
WELL LOCATION:	<u>Fine Sand</u>	90	100
sec. <u>7</u> T. <u>2</u> N. R. <u>11</u> E	<u>Coarse Sand</u>	100	110
<u>1</u> miles <u>N</u> of <u>Fyfe</u> (distance) (direction) (nearest town)			
WELL PURPOSE: <u>Home</u> (home, irrigation, municipal, industrial)			
WELL COMPLETION DATA:			
(1) diameter (inches) <u>4</u>			
(2) total depth (feet) <u>110</u>			
(3) static water level (feet) <u>30</u> below above top of ground.			
(4) casing <u>plastic, 102</u> (material) (depth)			
<u>4</u> (size) if telescope see back.			
(5) screen <u>8, 102</u> (length) (depth to top)			
<u>4</u> , <u>plastic</u> (size) (material)			
(6) pump <u>1/2</u> <u>10</u> (HP) (yield gpm)			
<u>electric</u> (type power)			
(7) electric log <u>no</u> (yes or no)			
(organization running log)			
(8) how well bottom plugged <u>sealed</u>			


CODED

RECEIVED
APR - 2 1975

DRILLERS REMARKS:

If well telescopes please sketch and show depths.

GROUND LEVEL

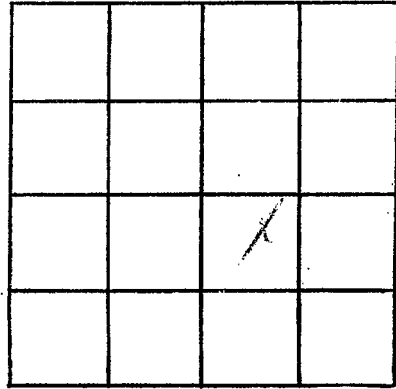

SECTION 7

Please indicate well location X.

ADDITIONAL INFORMATION

A series of horizontal lines for writing additional information, starting below the 'ADDITIONAL INFORMATION' header and extending to the bottom of the page.

If more than one screen, show locations of each on sketch.