

Walthall
F87
8/74

MISSISSIPPI
BOARD OF WATER COMMISSIONERS
416 North State Street
Jackson, Mississippi 39201

CODED

WATER WELL DRILLERS LOG¹³⁶

August 1974 date well completed
E. B. Sheppard firm name
Walthall county well located

LANDOWNER:
Winifred Ellzey
Tylertown, Miss.
(mailing address)

description of formations encountered	from	to
RED SANDY CLAY	0	80
SAND & LOOSE GR.	80	102

WELL LOCATION:
sec 16 T 2 N R 11 E
S W
2 1/2 miles NE of Tylertown
(distance) (direction) (nearest town)

WELL PURPOSE:
(home) irrigation, municipal, industrial

WELL COMPLETION DATA:

(1) diameter (inches) 2"

(2) total depth (feet) 102'

(3) static water level (feet) 60' below top of ground.

(4) casing pl 97' (material) (depth)
2" if telescope see back. (size)

(5) screen 5' (length) (depth to top)
2" pl (size) (material)

(6) pump 3/4 7 (HP) (yield gpm)
E (type power)

(7) electric log (yes or no)

(organization running log)

(8) how well bottom plugged B.W.V.


DRILLERS REMARKS:

RECEIVED
MAY - 8 1975

MISS. Bd. OF WATER COMM.

If well telescopes please sketch and show depths.

GROUND LEVEL

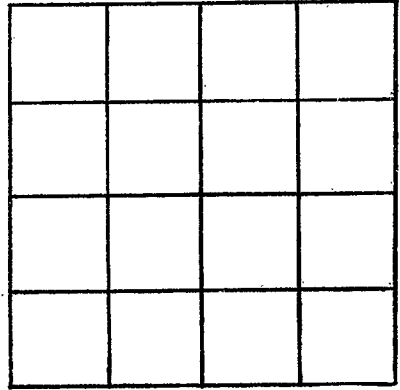

SECTION _____

Please indicate well location X.

ADDITIONAL INFORMATION

If more than one screen, show locations of each on sketch.