

Walthall
F-88
9/74

MISSISSIPPI
BOARD OF WATER COMMISSIONERS CODED CODED
416 North State Street
Jackson, Mississippi 39201

WATER WELL DRILLERS LOG

Sept. 1974 E. B. Sherrish, Walthall
date well completed firm name county well located

LANDOWNER:

Mrs Lollie Magee
Rt. 1 Sylveston, Ms.
(mailing address)

description of formations encountered

from to

SAND & GRAVEL @ 170'

WELL LOCATION:

sec. 12 T. 20 N R. 11 E
S W
5 miles NE of Sylveston
(distance) (direction) (nearest town)

WELL PURPOSE:

(home irrigation, municipal, industrial)

WELL COMPLETION DATA:

- (1) diameter (inches) 2"
- (2) total depth (feet) 120'
- (3) static water level (feet) 70' ^{below} _{above} top of ground.
- (4) casing pl. 115'
(material) (depth)
2" If telescope see back.
(size)
- (5) screen 5'
(length) (depth to top)
2" pl.
(size) (material)
- (6) pump 1 7
(HP) (yield gpm)
E
(type power)
- (7) electric log (yes or no)

(organization running log)

(8) how well bottom plugged Blw


DRILLERS REMARKS:

RECEIVED
MAY 8 1975

MISS. Bd. OF WATER COMMISSIONERS

If well telescopes please sketch and show depths.

GROUND LEVEL

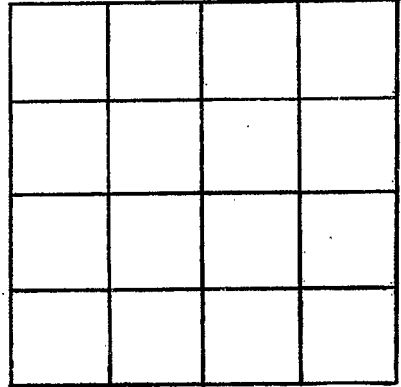

SECTION _____

Please indicate well location X.

ADDITIONAL INFORMATION

If more than one screen, show locations of each on sketch.