

Walthall  
F 89  
4/75

MISSISSIPPI  
BOARD OF WATER COMMISSIONERS  
416 North State Street  
Jackson, Mississippi 39201

CODED

WATER WELL DRILLERS LOG

April 1975 E. B. Sheppard Walthall  
Date well completed firm name county well located

LANDOWNER:

Lucious B. Quinn

Rt. 2 - Sylertown, Ms.  
(mailing address)

description of formations encountered

from to

GRAY SANDY CLAY	0	60'
LOOSE SMALL GRAY SAND	60'	90'
COARSE SAND & GRAVEL	90'	122'

WELL LOCATION:

sec. 1 T. 2 N R. 14 E  
6 miles NE Sylertown  
(distance) (direction) (nearest town)

WELL PURPOSE:

(home) irrigation, municipal, industrial

WELL COMPLETION DATA:

- (1) diameter (inches) 2"
- (2) total depth (feet) 122'
- (3) static water level (feet) 55' <sup>below</sup> top of ground
- (4) casing pl. 117' (material) (depth)  
2" (size) if telescope see back.
- (5) screen 5' (length) (depth to top)  
2" (size) pl. (material)
- (6) pump 1 (HP) 7 (yield gpm)  
E (type power)
- (7) electric log (yes or no)

(organization running log)

(8) how well bottom plugged BWV


DRILLERS REMARKS:

RECEIVED  
MAY 8 1975

MISS. BD. OF WATER COMMISSIONERS

If well telescopes please sketch and show depths.

GROUND LEVEL

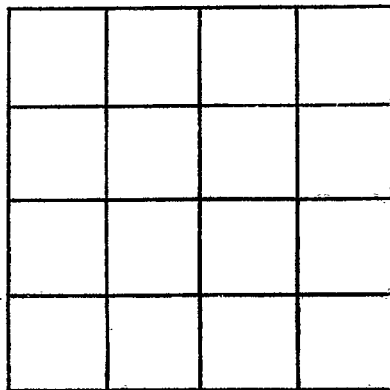

SECTION \_\_\_\_\_

Please indicate well location X.

ADDITIONAL INFORMATION

If more than one screen,  
show locations of each on sketch.