

F 90
Walthall
5/29/75


MISSISSIPPI
 BOARD OF WATER COMMISSIONERS
 416 North State Street
 Jackson, Mississippi 39201

CODED

WATER WELL DRILLERS LOG

5-29 1975 Fitzgerald Walthall
 date well completed firm name county well located

LANDOWNER:	description of fomations encountered	from	to
<u>Sadie Stein</u> <u>RR. Tylston</u> (mailing address)			
WELL LOCATION:			
sec. <u>6</u> T. <u>2</u> N. R. <u>11</u> E. <u>3</u> miles <u>N</u> of <u>Tylston</u> (distance) (direction) (nearest town)			
WELL PURPOSE: (home, irrigation, municipal, industrial)			
WELL COMPLETION DATA:			
(1) diameter (inches) <u>4</u>			
(2) total depth (feet) <u>68</u>			
(3) static water level (feet) <u>35</u> below above top of ground.			
(4) casing <u>plastic</u> <u>60</u> (material) (depth)			
<u>4</u> If telescope see back. (size)			
(5) screen <u>8</u> <u>60</u> (length) (depth to top)			
<u>4</u> <u>plastic</u> (size) (material)			
(6) pump <u>1/2</u> <u>10</u> (HP) (yield gpm)			
<u>9kw</u> (type power)			
(7) electric log <u>no</u> (yes or no)			
(organization running log)			
(8) how well bottom plugged <u>Seal thick</u>			
DRILLERS REMARKS:			

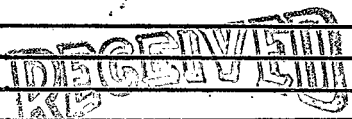


JUN 10 1975

MISSISSIPPI BOARD OF WATER COMMISSIONERS

If well telescopes please sketch and show depths.

GROUND LEVEL

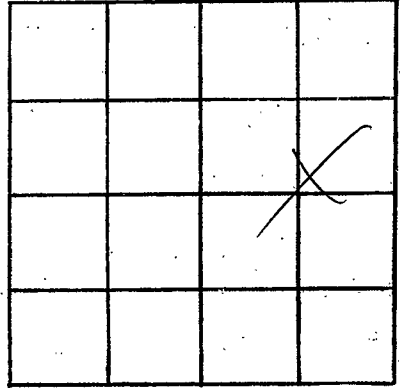

SECTION 6

Please indicate well location X.

ADDITIONAL INFORMATION

If more than one screen, show locations of each on sketch.