

Walthall
F 91
4-16-75

MISSISSIPPI
BOARD OF WATER COMMISSIONERS
416 North State Street
Jackson, Mississippi 39201
WATER WELL DRILLERS LOG

CODED

4/16/75 19 STAFFORD WELL SER WALTHALL
date well completed firm name county well located

LANDOWNER: Ort Holmes
Yuletown, Miss

(mailing address)

description of formations encountered	from	to
top soil	0	15
clay & gravel	15	45
chalk	45	100
sand & gravel	100	130

WELL LOCATION:

sec. 2 T 2 N R 11 E ^{13V}
4 miles North of Yuletown
(distance) (direction) (nearest town)

WELL PURPOSE:
(home, irrigation, municipal, industrial)

WELL COMPLETION DATA:


- diameter (inches) 4
- total depth (feet) 130 ft.
- static water level (feet) 95' below top of ground
- casing plastic 120 ft.
(material) (depth)
4" if telescope see back.
(size)
- screen 10 ft. 120 ft.
(length) (depth to top)
4" plastic
(size) (material)
- pump _____
(HP) (yield gpm)
(type power)
- electric log _____
(yes or no)
(organization running log)
- how well bottom plugged BSWV.

DRILLERS REMARKS:

Halmae Dyer

If well telescopes please sketch and show depths.

GROUND LEVEL

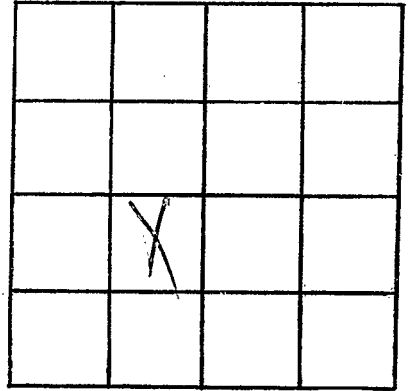

SECTION 2

Please indicate well location X.

ADDITIONAL INFORMATION

If more than one screen,
show locations of each on sketch.