

Walthall  
F 92  
8-14-75

MISSISSIPPI  
 BOARD OF WATER COMMISSIONERS  
 416 North State Street  
 Jackson, Mississippi 39201

CODED

WATER WELL DRILLERS LOG

Aug 14 1975 Reuss Mill/Kidley Walthall  
 date well completed firm name county well located

LANDOWNER:	description of formations encountered	from	to
<u>ms. Pauline (Queen) Wilson</u> <u>P.O. Tylitown</u> (mailing address)			
WELL LOCATION:			
sec. <u>29</u> T. <u>2</u> N. R. <u>11</u> E. <u>1</u> miles <u>East</u> of <u>Tylitown</u> (distance) (direction) (nearest town)	CODED		
WELL PURPOSE: <u>home</u> (home, irrigation, municipal, industrial)			
WELL COMPLETION DATA:			
(1) diameter (inches) <u>4"</u>			
(2) total depth (feet) <u>207</u>			
(3) static water level (feet) <u>24</u> below top of ground.			
(4) casing <u>plastic bottom</u> (material) (depth)			
<u>6'</u> If telescope see back. (size)			
(5) screen <u>6'</u> <u>201</u> (length) (depth to top)			
<u>4"</u> <u>plastic</u> (size) (material)			
(6) pump <u>1 1/2 HP</u> <u>10</u> (HP) (yield gpm)			
<u>elect</u> (type power)			
(7) electric log <u>no</u> (yes or no)			
(organization running log)			
(8) how well bottom plugged: <u>wooden plug</u>			
DRILLERS REMARKS: <u>2" well screen</u> <u>well bad?</u>			


MISSISSIPPI BOARD OF WATER COMMISSIONERS

OCT 20 1975

MISS. BD. OF WATER COMMISSIONERS

If well telescopes please sketch and show depths.

GROUND LEVEL

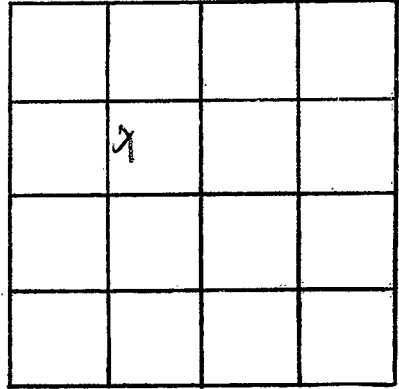

SECTION 29

Please indicate well location X.

ADDITIONAL INFORMATION

If more than one screen,  
show locations of each on sketch.