

No. MS-6W-1398

WALTHAM
F94
6-76
Elev #68

MISSISSIPPI
BOARD OF WATER COMMISSIONERS
416 North State Street
Jackson, Mississippi 39201

CODED

WATER WELL DRILLERS LOG

June 19 76 ARNER DRILLING SERVICE WALTHAM
date well completed firm name county well located

LANDOWNER: TOWN OF TYLER TOWN, WELL No. 2
(mailing address)
WELL LOCATION: SW 1/4 NE 1/4 SW 1/4
sec. 19 T. 2 N. R. 11 E.
S W
_____ miles _____ of _____
(distance) (direction) (nearest town)

description of formations encountered	from	to
Clay (white near top)	0	130
Sand, Fine	130	160
Clay	160	240
Small pea gravel	240	346
CLAY	346	408
SAND, Fine	408	420

WELL PURPOSE:
(home, irrigation, municipal, industrial)

CODED

WELL COMPLETION DATA:

- (1) diameter (inches) 16"
- (2) total depth (feet) 342'
- (3) static water level (feet) 16' below above
top of ground.
- (4) casing steel 282'
(material) (depth)
16" If telescope see back.
(size)
- (5) screen 50' 292'
(length) (depth to top)
8" 304 Sis. Screen
(size) (material)
- (6) pump 75 500
(HP) (yield gpm)
ELECT.
(type power)
- (7) electric log YES
(yes or no)
MCS
(organization running log)
- (8) how well bottom plugged BRK
WASH VALVE

RECEIVED


SEP 23 1976

DRILLERS REMARKS:

MISS. BD. OF WATER COMM.

②
If well telescopes please
sketch and show depths.

GROUND LEVEL

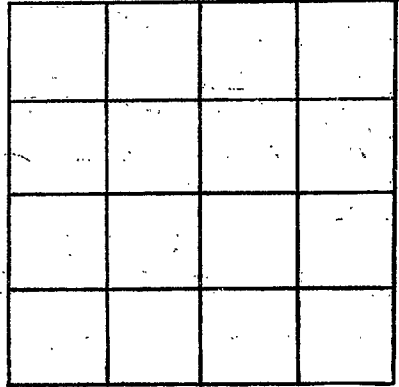

SECTION _____

Please indicate well location X.

ADDITIONAL INFORMATION

If more than one screen,
show locations of each on sketch.