

WALTHALL
F 96
8-14-79

MISSISSIPPI
BOARD OF WATER COMMISSIONERS
416 North State Street
Jackson, Mississippi 39201

CODED

WATER WELL DRILLERS LOG

8-14 1979 Griner Drilling Walthall
date well completed firm name county well located

LANDOWNER:

Marion Drilling
P.O. Box 16606
Mobile, Ala
(mailing address)

description of formations encountered

from to

Top Soil	0	21
clay, gravel	21	63
gravel + sand	63	105
pea gravel - sand	105	273
gravel	273	336
Clay	336	357
sand + clay	357	379
sand	379	450

WELL LOCATION:

1000N + 1725E
sec. 25 T 2 N R 11 E of
7 miles E of Tyler town
(distance) (direction) (nearest town)

WELL PURPOSE:

oil field supply
(home, irrigation, municipal, industrial)

CODED

WELL COMPLETION DATA:

- diameter (inches) 3"
- total depth (feet) 450'
- static water level (feet) 70' ⁶⁶low above top of ground
- casing Steel 420' (material) (depth)
3" (size) if telescope see back.
- screen 42' 378' (length) (depth to top)
3" perforated (size) (material)
- pump - 75 (HP) (yield gpm)
AC (type power)
- electric log (yes or no)
- (organization running log)

(8) how well bottom plugged

orange
peel

Miss. Board of Water Comm.


DRILLERS REMARKS:

SEP 17 1979

RECEIVED

If well telescopes please sketch and show depths.

GROUND LEVEL

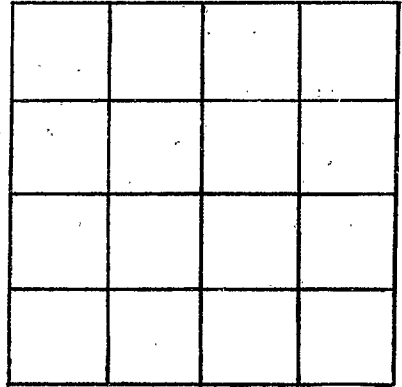

SECTION _____

Please indicate well location X.

ADDITIONAL INFORMATION

If more than one screen,
show locations of each on sketch.