

MISSISSIPPI DEPARTMENT OF NATURAL RESOURCES

Bureau of Land and Water Resources

Southport Mall

P.O. Box 10631

Jackson, Mississippi 39209

**CODED**

WATER WELL DRILLERS LOG

<i>Walshale</i>
<i>F 98</i>
<i>7-1-81</i>

*Griner Drilling Service, Inc.*

*Walshale*

date well completed

firm name

county well located

LANDOWNER:

description of formations encountered

from

to

*Louisiana Land & Exploration*  
*P.O. Box 60350*  
*New Orleans, La 70160*  
(mailing address)

*sand + pea gravel 0 420*

WELL LOCATION: *DM N 2151 E*

*NO1 sec 25 T 20 N R 11 E of*  
*mittell Tylertown*  
(distance) (direction) (nearest town)

WELL PURPOSE: *oil field supply*  
(home, irrigation, municipal, industrial)

WELL COMPLETION DATA:

(1) diameter (inches) *4"*

(2) total depth (feet) *420'*

(3) static water level (feet) *90'* *below* above top of ground.

(4) casing *steel* *420'*  
(material) (depth)

*4"*  
(size) if telescope see back.

(5) screen *42'* *378'*  
(length) (depth to top)

*4"* *perforated*  
(size) (material)

(6) pump *—* *80*  
(HP) (yield gpm)

*AC*  
(type power)


(7) electric log *—*  
(yes or no)

(organization running log)

(8) how well bottom plugged *orange*


DRILLERS REMARKS:

**CODED**

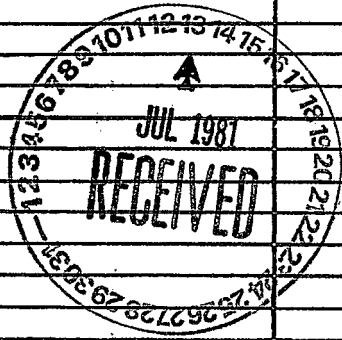

If well telescopes please  
sketch and show depths.

GROUND LEVEL

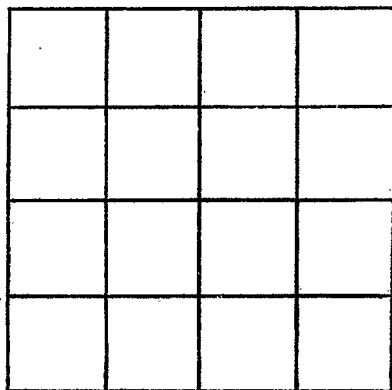

SECTION \_\_\_\_\_

Please indicate well location X.

ADDITIONAL INFORMATION

If more than one screen,  
show locations of each on sketch.